

SURVEY NO. 1226

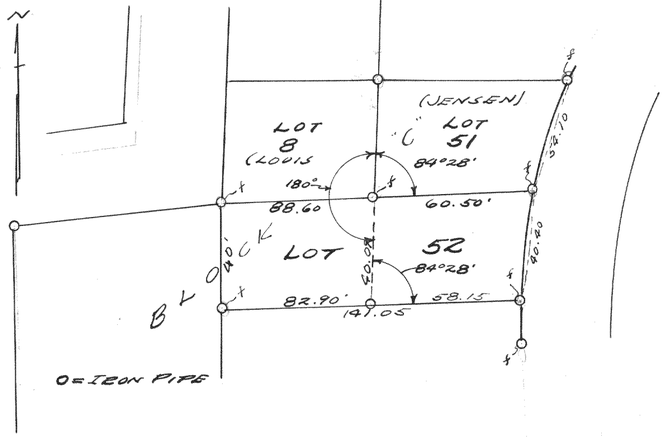

PLAT OF SURVEY OF LOT 52 OF BLOCK "C" OF CISCO BEACH SUBD.
AUG. 1941
Lloyd L Jensen
R.E.J.

SURVEY NO. 1227

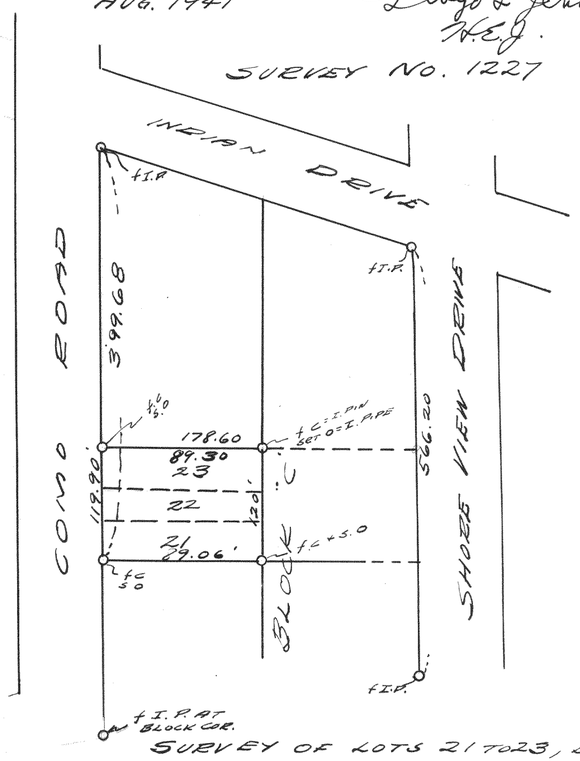

SURVEY OF LOTS 21 TO 23, BLOCK "C" OF CISCO BEACH SUBD.
Lloyd L Jensen
REG.

SURVEY NO. 1228



PLAT OF SURVEY OF LOTS 11+12 OF BLK. 12 OF UNIT "B" OF SUNSET HILLS SUBD., WAL. COUNTY, WISCONSIN.
DEC. 6, 1941
Lloyd L Jensen
R.E.J.