
#1639

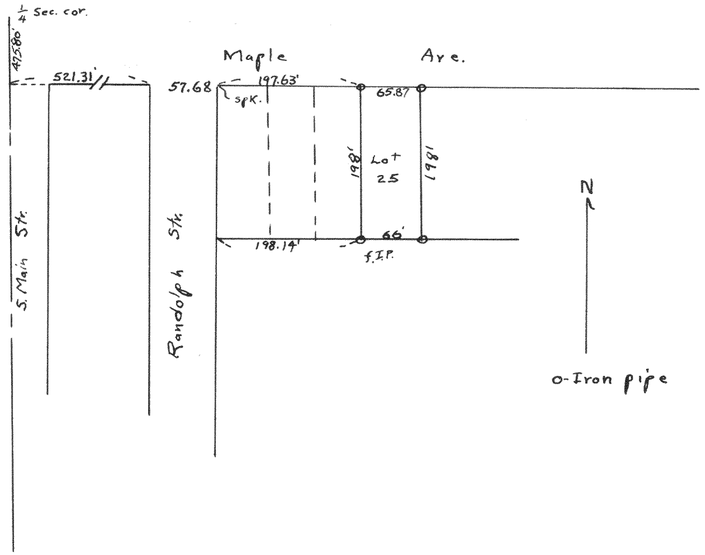


Plat of survey of lot 25 of Clarkes Addition to the Village of Walworth, Walworth County, Wisconsin

June 3, 1946

Lloyd L. Jensen
County Surveyor
G.T.D.

#1640

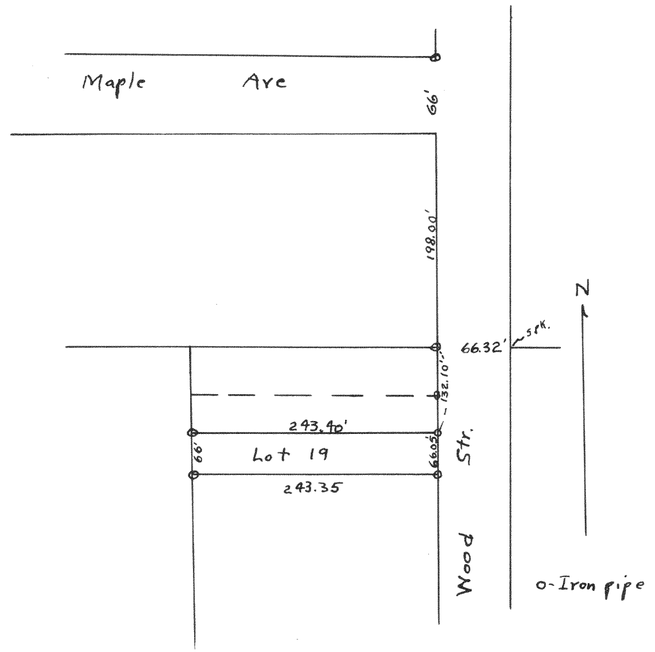

Plat of survey of lot 19 of Clarkes 2nd Addition to the Village of Walworth, Walworth County, Wisconsin

June 3, 1946

Lloyd L. Jensen
County Surveyor
G.T.D.