
#1641

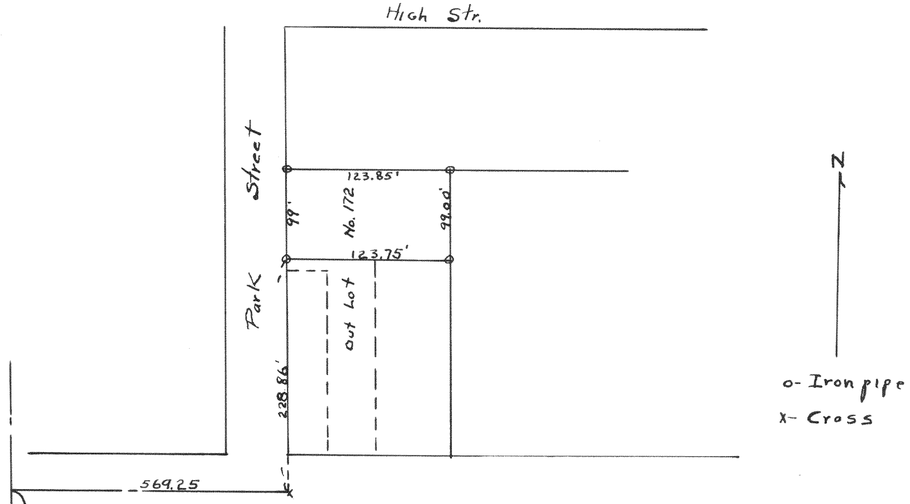


Plat of part of Outlot No. 172 of Assessors plat of the Village of Walworth, Walworth County, Wisconsin

June 1946

Lloyd L. Jensen
County Surveyor
G.T.D.

#1642

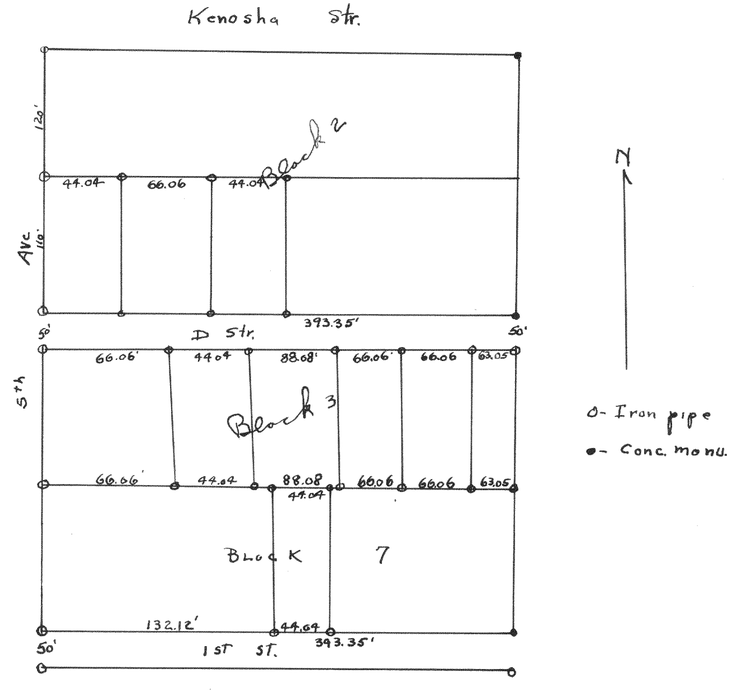

Plat of survey of part of Block 2 and all of Block 3 of East Side Addition and part of Block 7 of East Side 2nd Addition to the Village of Walworth, Walworth County, Wisconsin

1946

Lloyd L. Jensen
County Surveyor
G.T.D