
#1643

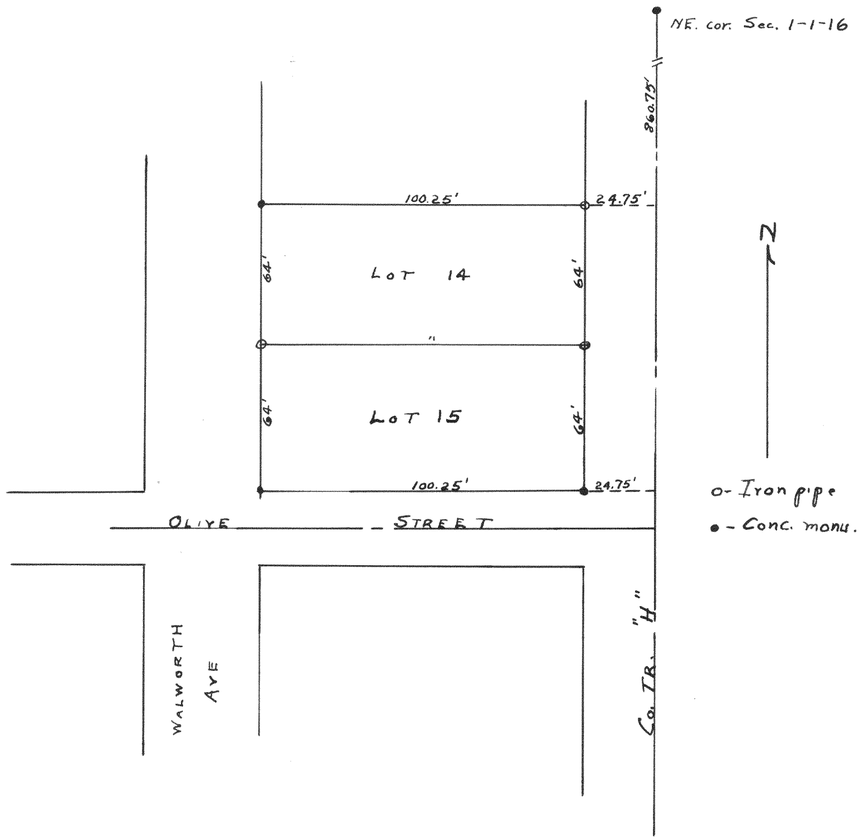


Plat of survey of lots 14 and 15 of Wm. H. Francis Subdivision in the Village of Williams Bay, Walworth County Wisconsin

Dec. 1946

Lloyd L. Jensen
County Surveyor
G.T.D.

#1644

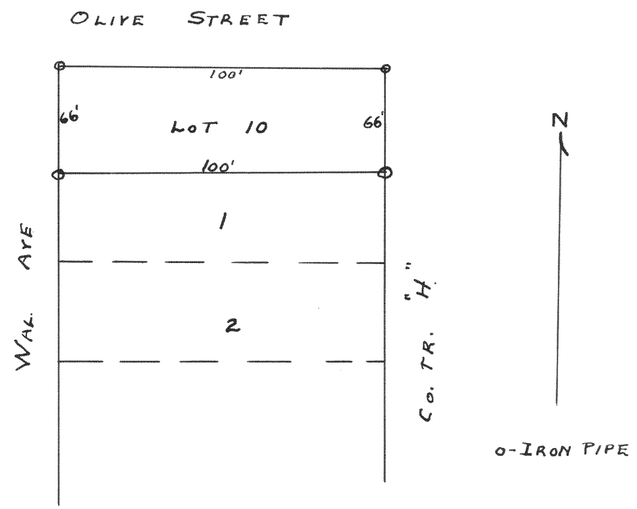

Plat of survey of lot 10 of addition No. 1 to the Village of Williams Bay, Walworth county Wisconsin

Dec. 1946

Lloyd L. Jensen
county surveyor
G.T.D