
#1645

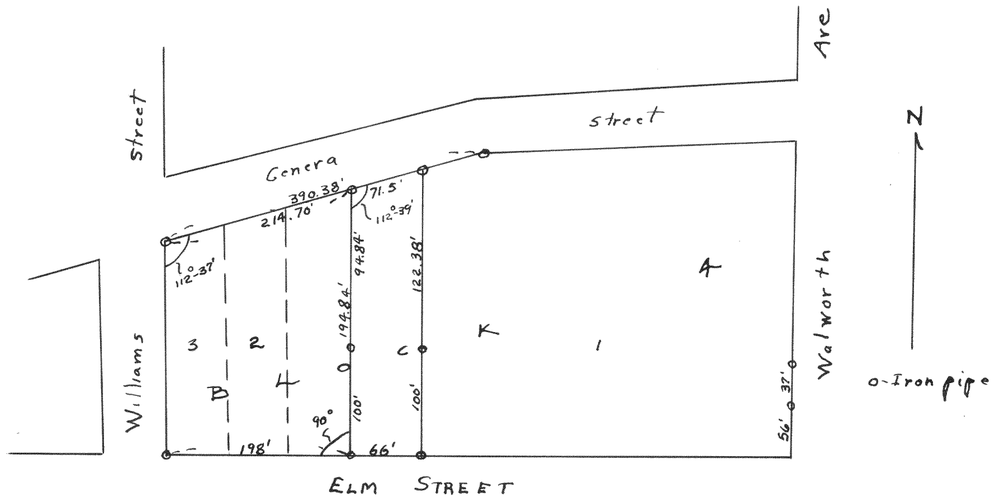


Plat of survey of part of lot 1 of Block 4 of the original plat of the village of Williams Bay, Walworth County Wisconsin

May 25, 1946

Lloyd L. Jensen
County Surveyor
G.T.D

#1646

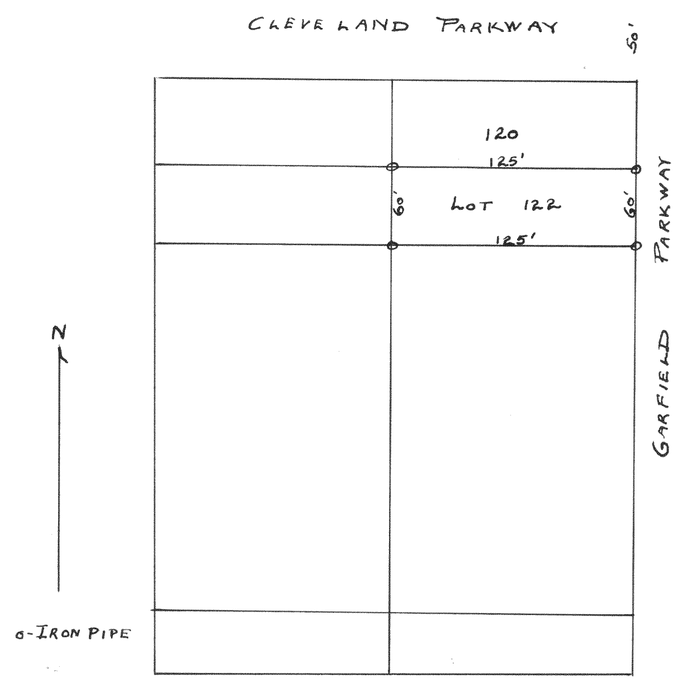

Plat of survey of lot 122 of the original Cedar Point Park subdivision of Williams Bay, Walworth County, Wisconsin

Sept. 1946

Lloyd L. Jensen
County Surveyor
G.T.D