
#1647

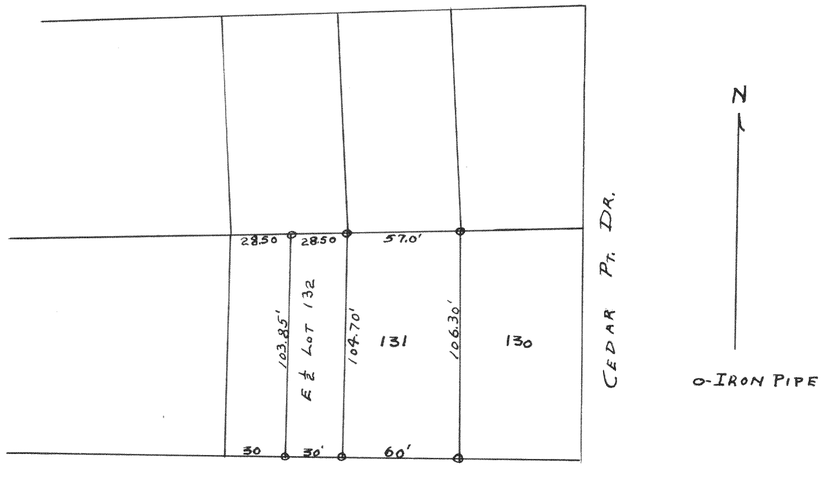

N


O-IRON PIPE

Plat of survey of lot 131 and the East ½ of lot 132 of the 2nd Addition to Cedar Point Park, Williams Bay, Wisconsin

May 23, 1946

Lloyd I. Jensen
County Surveyor
G.T.D

#1648

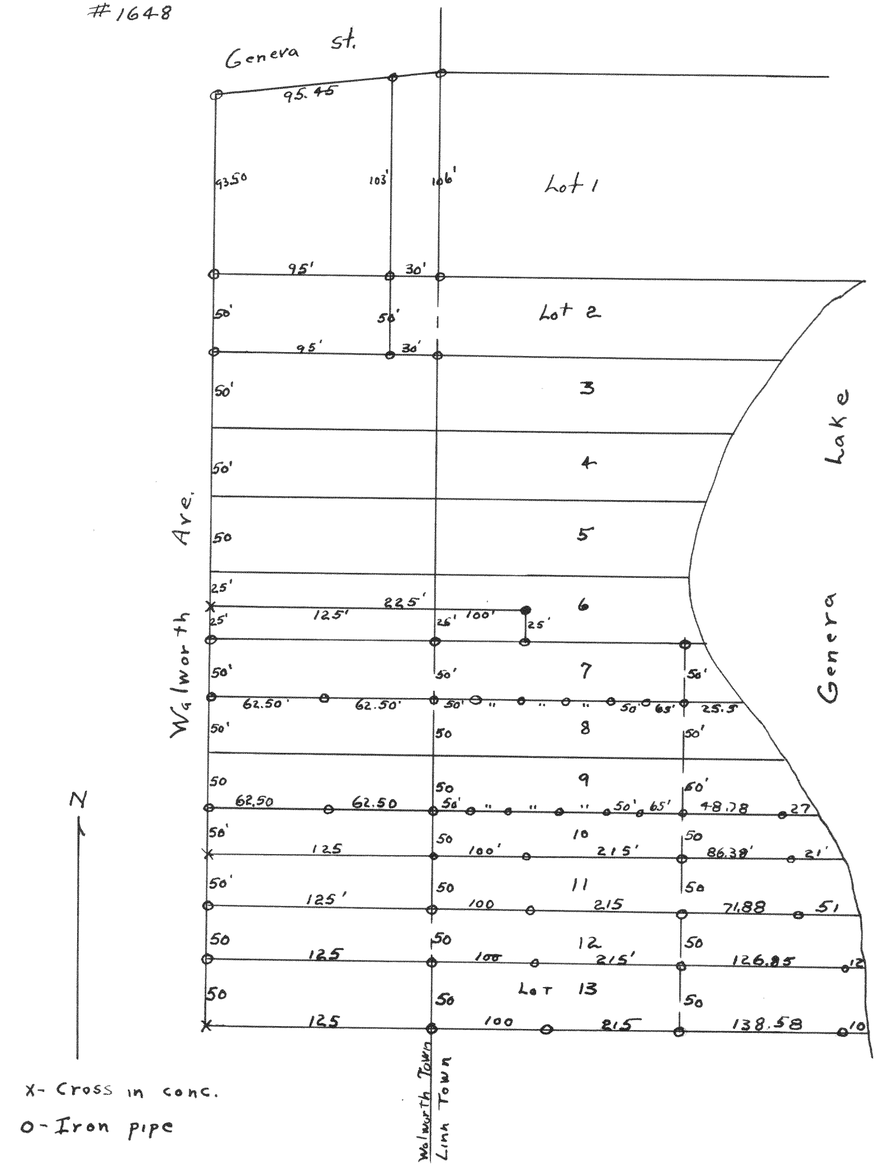

N

X- Cross in conc.

O-Iron pipe

Plat of survey for several owners in Block 7 of the original plat of the Village of Williams Bay Walworth County Wisconsin

Dec. 10, 1946

Lloyd I Jensen
County Surveyor
G.T.D