
#1649

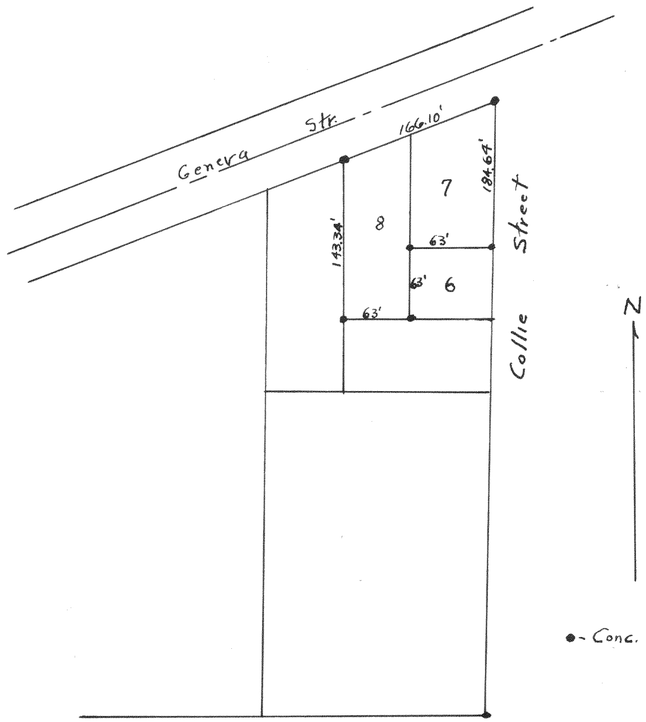


Plat of survey of lots 7 and 8 of Madison Addition to the Village of Williams Bay, Walworth County, Wisconsin

Dec 10, 1946

Lloyd I Jensen
County Surveyor
G.T.D

#1650

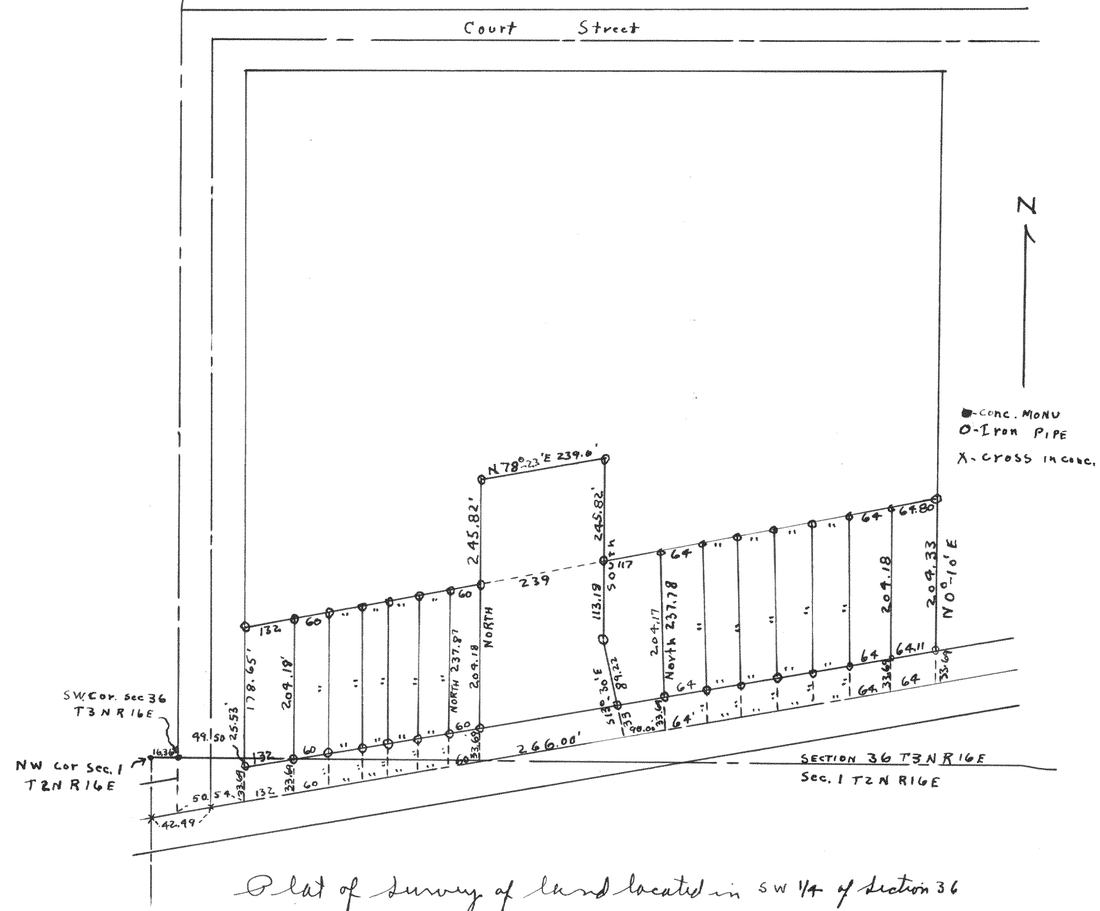

Plat of Survey of land located in SW 1/4 of Section 36 T 3 N R 16 E and in the NW 1/4 of Section 1 T 2 N R 16 E in the City of Elkhorn, Walworth County, Wisconsin
April 22, 1946

Lloyd I Jensen
County Surveyor
G.T.D