
#1651

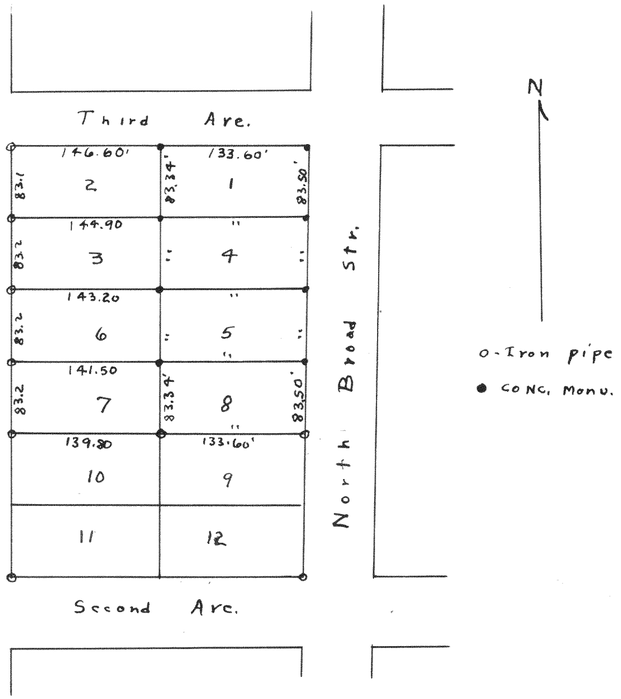


Plat of Survey of Lots 1, 4, 5, and 8 in Block 46, Davis Addition to the City of Elkhorn, Walworth County Wisconsin

May 29, 1946

Lloyd L Jensen
County Surveyor
G.T.D

#1652

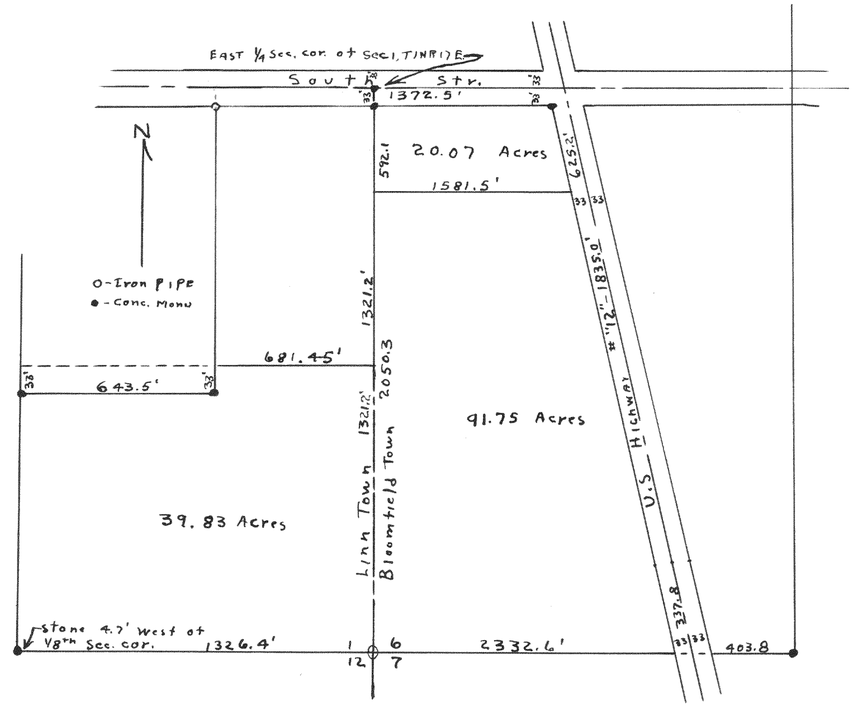

Plat of Survey of land located in Section 1, T1NR17E and in Section 6, T1NR18E of Walworth County, Wisconsin

May 1946

Lloyd L Jensen
County Surveyor
C.T.D