
#1653

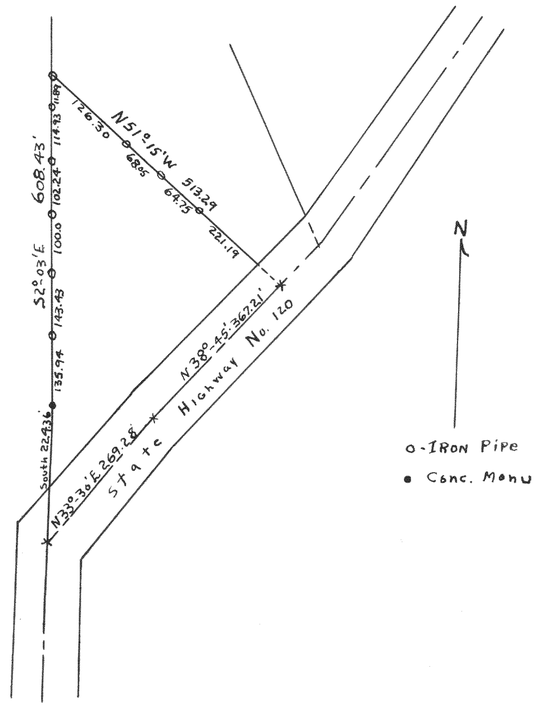


Plat of survey of lands located in the Northwest fractional quarter and the SW 1/4 of section 12 T 1N, R 17E of Walworth County Wisconsin

Feb. 10, 1947

Lloyd L. Jensen
County Surveyor
G.T.D

#1654

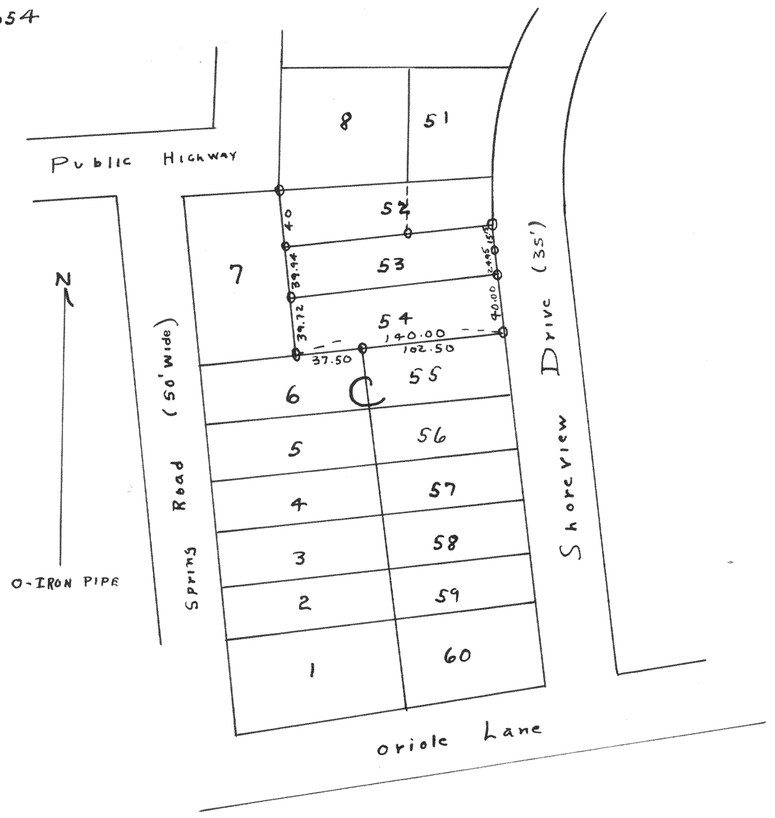

Plat of survey of lots 53 and 54 of Block C of Cisco Beach Subdivision, T 1N, R 17E of Walworth County Wisconsin

Sept 1946

Lloyd L Jensen
County Surveyor
G.T.D