
#1655

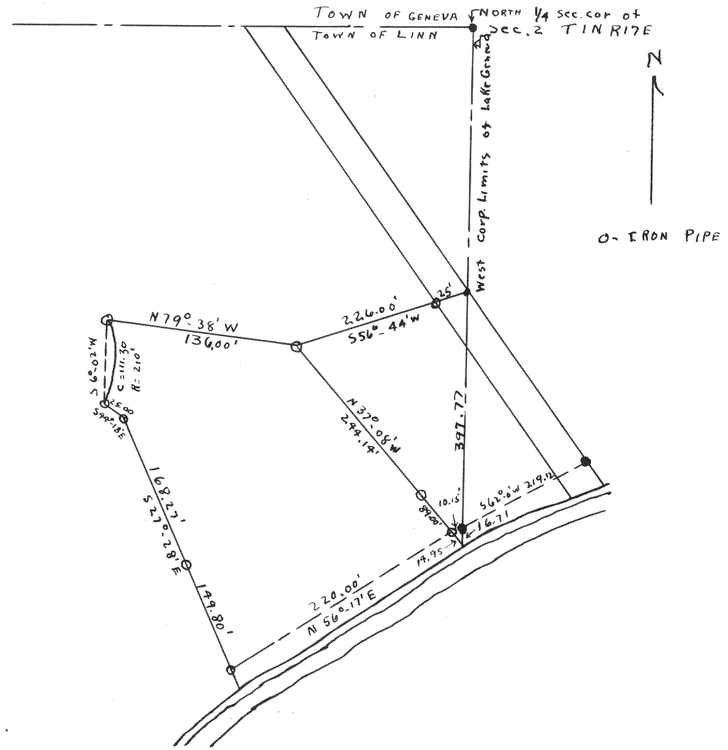


Plat of survey of land located in the NW1/4 of Section 2 T1N, R17E of Walworth County, Wisconsin

Sept 1946

Lloyd L. Jensen
County Surveyor
G.T.D

#1656

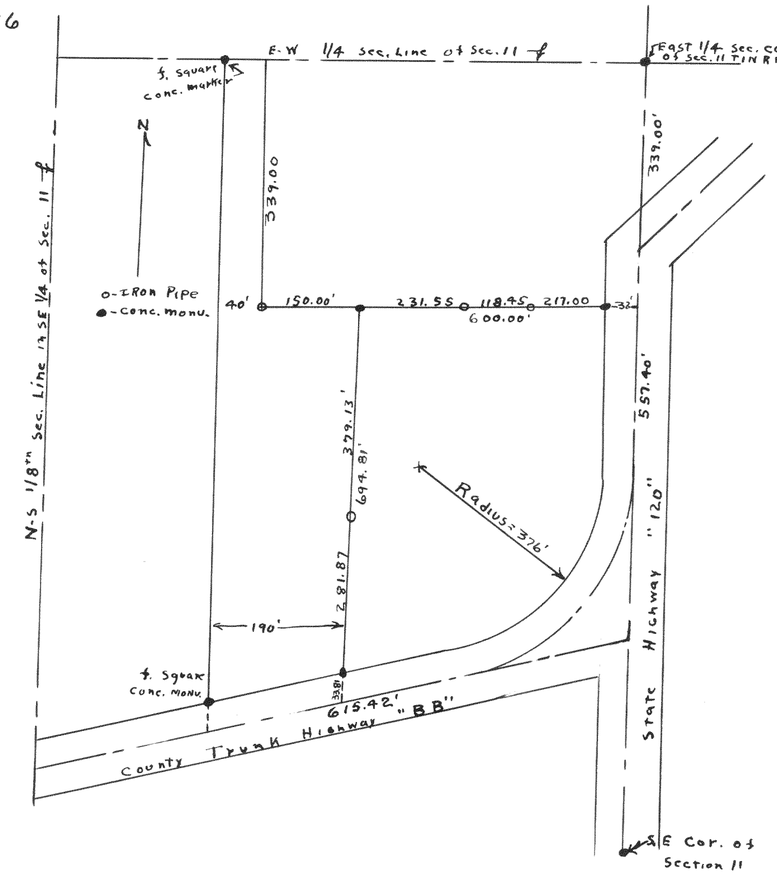

Plat of survey of land located in the SW1/4 of Section 11, T1N R17E of Walworth County, Wisconsin

Sept 1946

Lloyd L. Jensen
County Surveyor
G.T.D