
#1657

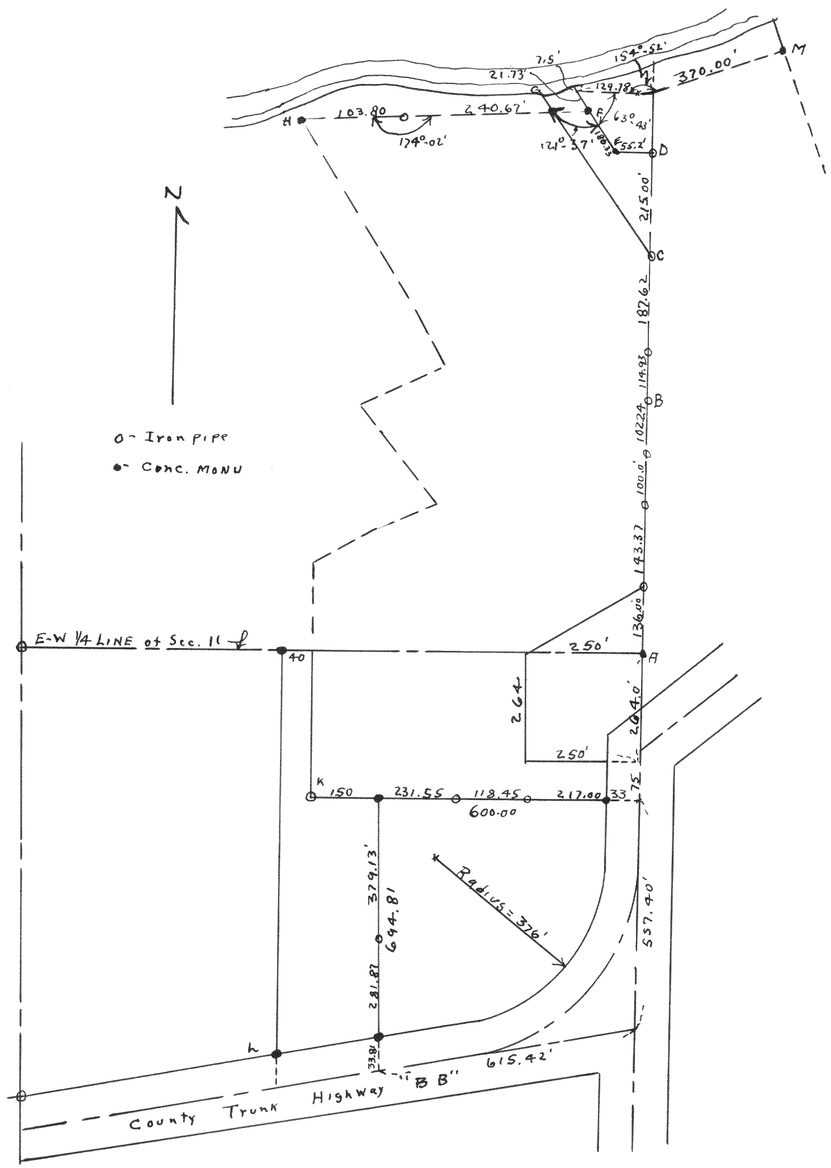


Plat of survey of land located in the SW 1/4 and the NE fractional 1/4 of Section 11, T1N R17E of Walworth County Wisconsin

Dec. 1946

Lloyd L Jensen
County surveyor
G.T.D

#1658

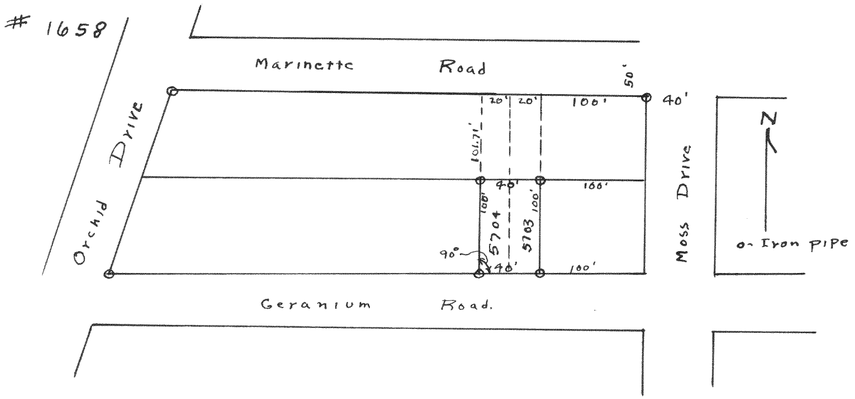


Plat of survey of lots 5703 and 5704 of Block 103 of Section 3 of Bell Lake Subdivision T1N, R18E Walworth county, Wisconsin

Aug 1946

Lloyd L Jensen
County Surveyor
G.T.D

#1659

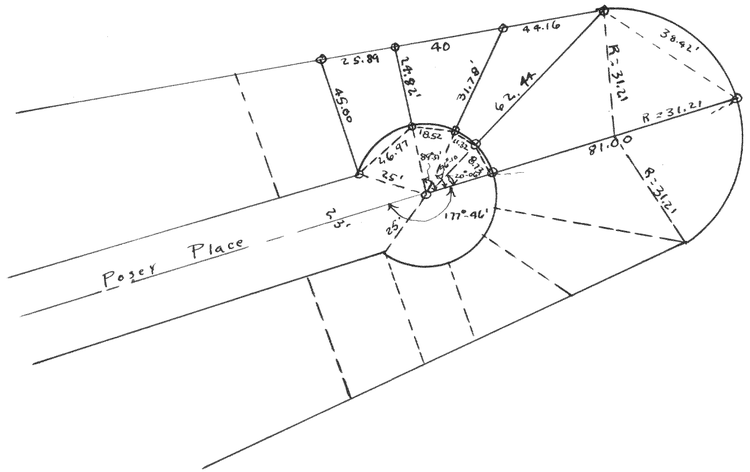

Plat of survey of Lots 9405 to 9408 of Sec. 6 of Bell Lake, Walworth County Wisconsin

June 16, 1946

Lloyd L. Jensen
County Surveyor
G.T.D