
#1667

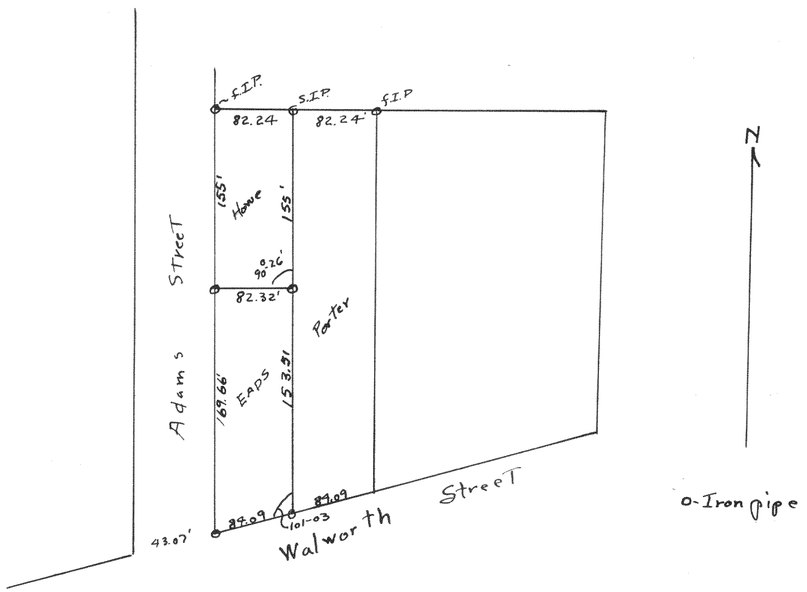


Plat of a survey of land located at the Corners of Adams and Walworth streets in the city of Elkhorn, Walworth County, Wisconsin
April 6, 1946

Lloyd L. Jensen
County Surveyor

C.T.D

#1668

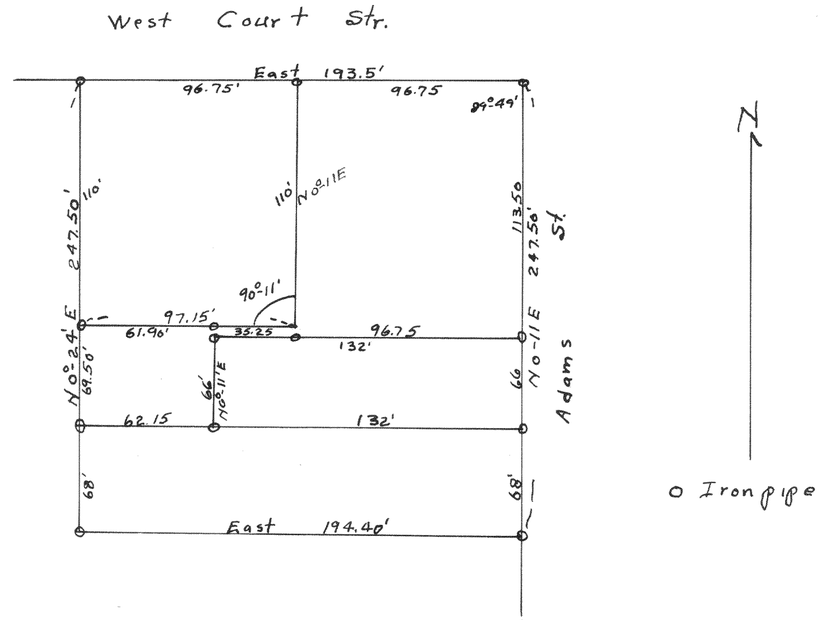

Plat of Survey of land located at the Corner of West Court and Adams streets in the city of Elkhorn, Walworth County, Wisconsin
May 3, 1946

Lloyd L. Jensen
County Surveyor