
#1668½

Plat of Nemes Subdivision in the City of Elkhorn, Section 36, T3N R16E, Walworth County Wis., see recorded plat on file in the Register of Deeds office at the County Court House.

May 1946

Lloyd L. Jensen
County Surveyor


#1669

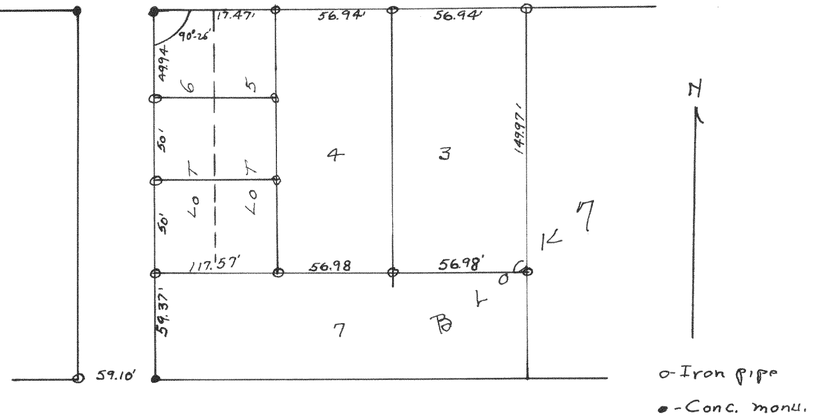

Plat of survey of lots 3, 4, 5, and 6 of Block 7 of Fairview Heights in the city of Delavan, Walworth County, Wis.
June 1946

Lloyd L. Jensen
County Surveyor
G.T.T

#1670

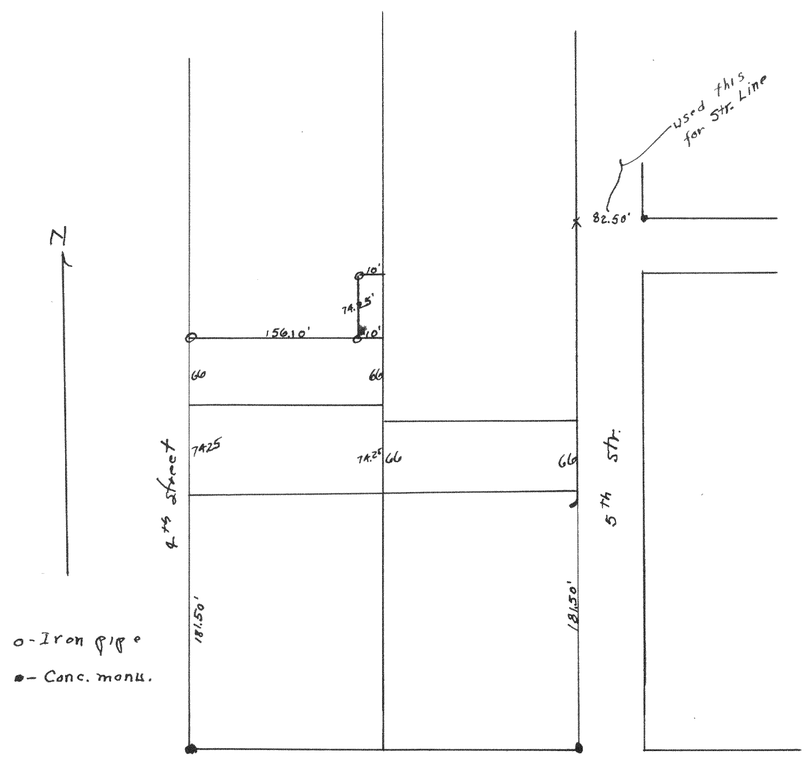

Plat of survey of land located between 4th and 5th Streets in the city of Delavan, Walworth county Wisconsin,
December 1946

Lloyd L. Jensen
County Surveyor
G.T.J