
#1671

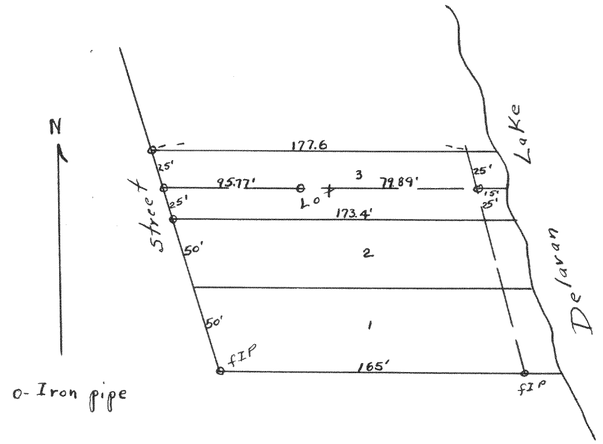


Plat of a survey to divide lot 3 of annex to Inlet Oaks Subdivision into 2 equal lots. Town of Delavan, Walworth County Wisconsin

Aug. 20, 1946

Lloyd L. Jensen
County Surveyor
G.T.D.

#1672

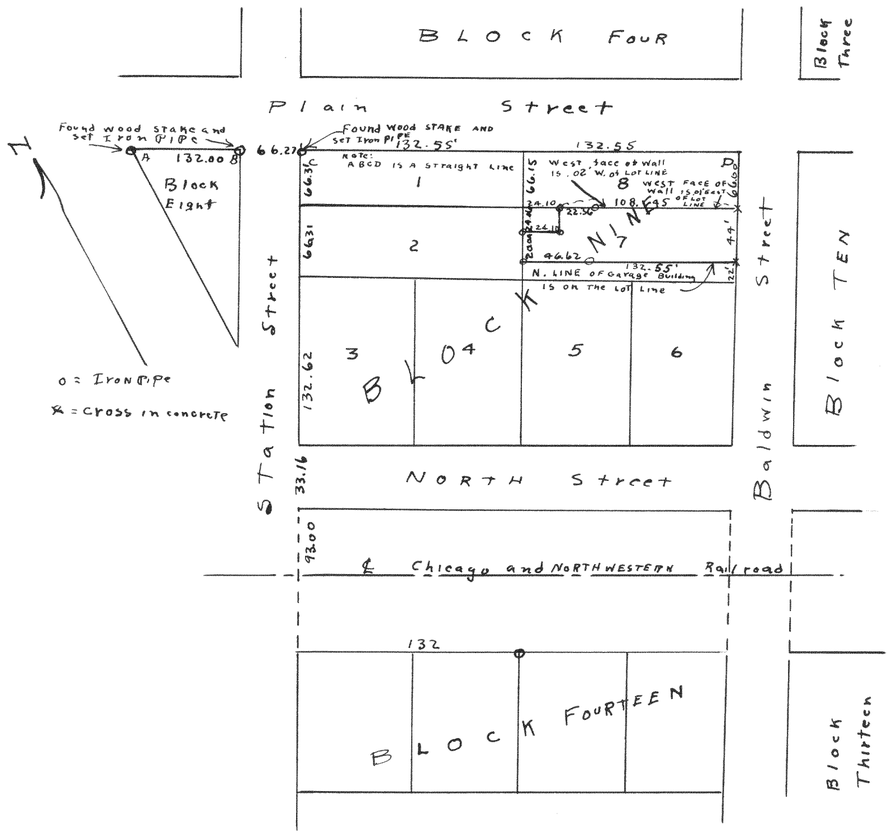

Plat of survey of part of Lot 7, Block 9 of the original Village of Sharon, Walworth County, Wisconsin

March 29, 1946.

Lloyd L. Jensen
County Surveyor
G.T.D.