

#1673

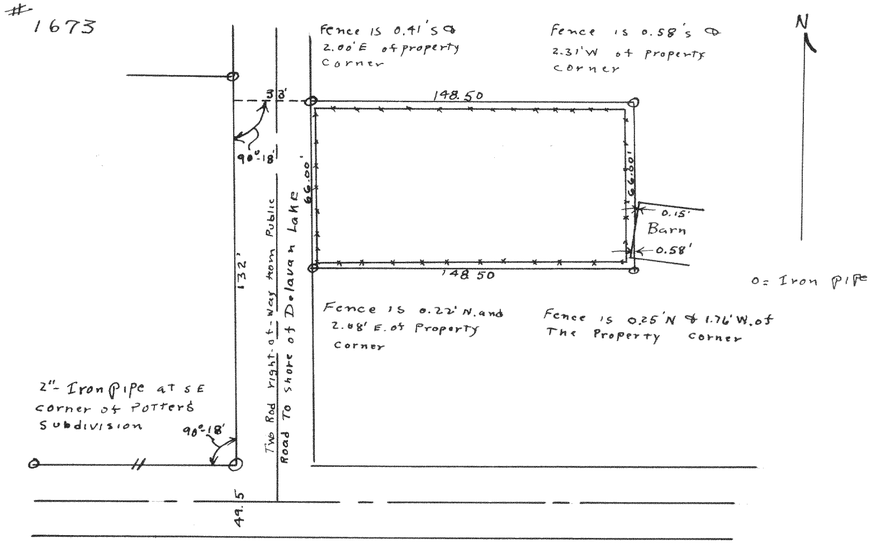

Plat of survey of a parcel of land located in Section 32 T 2 N R 16 E in Walworth County Wisconsin
Sept 1946

Lloyd L Jensen
Walworth County Surveyor
G.T.D


#1674

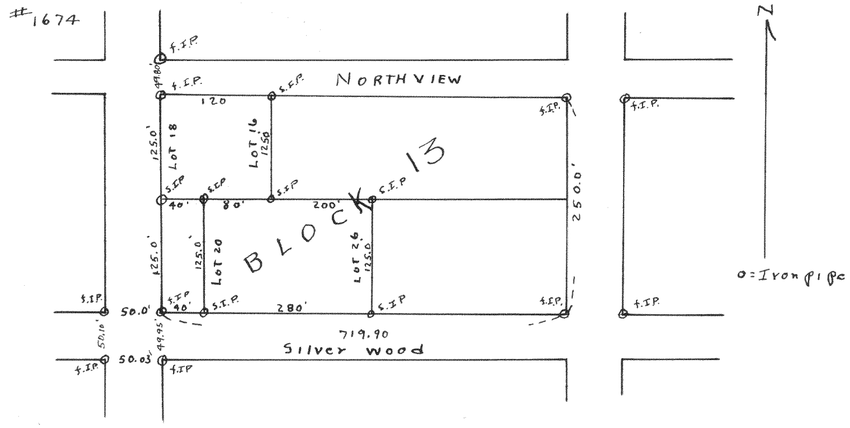

Plat of survey of lots 16 to 18, and lots 20 to 26 of Block 13 of Delavan Lakeview Crest Subdivision, Walworth County, Wisconsin
Sept 18, 1946

Lloyd L. Jensen
County Surveyor
G.T.D


#1675

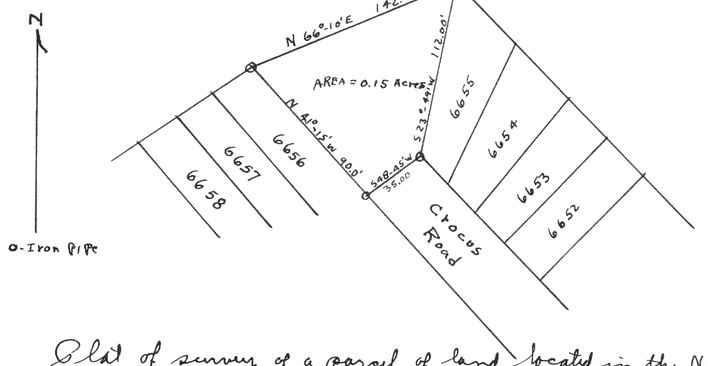

Plat of survey of a parcel of land located in the NE 1/4 of Section 15, T 1N, R 18E of Walworth County, Wisconsin
August 17, 1946

Lloyd L. Jensen
County Surveyor
G.T.D

#1676

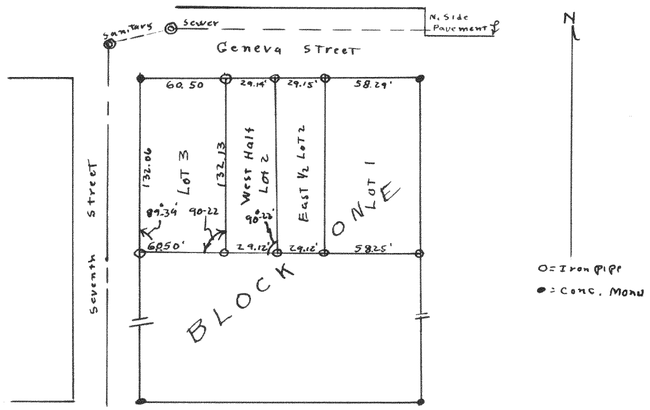

Plat of survey of Lots 1, 2, and 3 of Block one of Fairview Heights City of Delavan, Walworth County Wisconsin
March 26, 1946

Lloyd L. Jensen
County Surveyor
G.T.D