
#1677

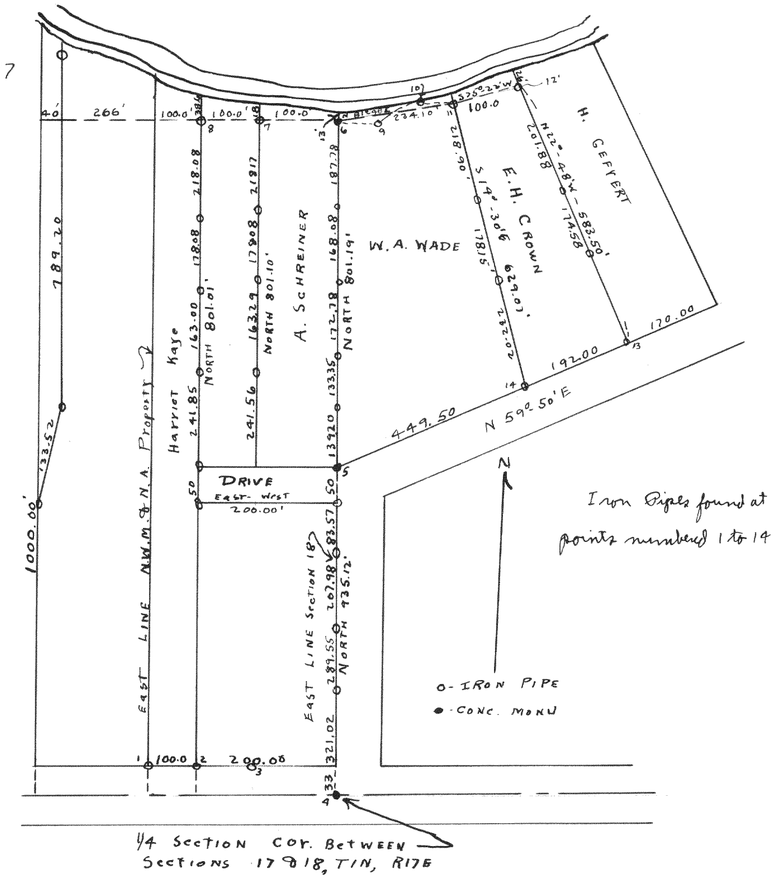


Plat of survey of lands located in the NW fractional 1/4 of section 17 and NE fractional 1/4 of section 18, T1N, R17E Walworth County Wisconsin

Nov. 18, 1946

Lloyd I. Jensen
County Surveyor
G.T.D

#1678

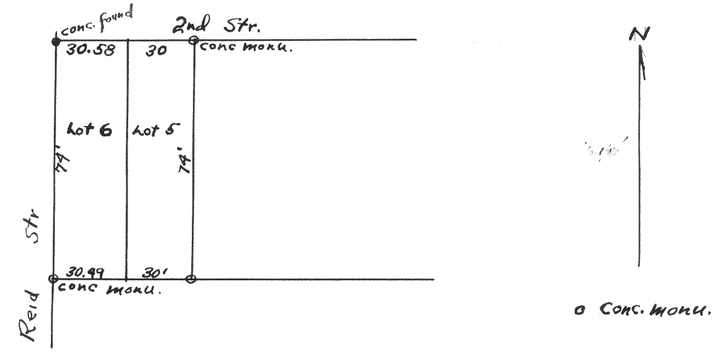

PLAT OF SURVEY OF LOTS 5+6 of block 5 of D.G. REIDS ADD. TO THE VILLIAGE OF FOUNTANA

March 1946

Lloyd I. Jensen
Co. Surv.

#1679 Plat of survey of McKenna Addition to the City of Lake Geneva and the Town of Geneva - see recorded plat in the Register of Deeds office at the County Court House.

Lloyd I. Jensen
County Surveyor

Mar. 1947