

#1682

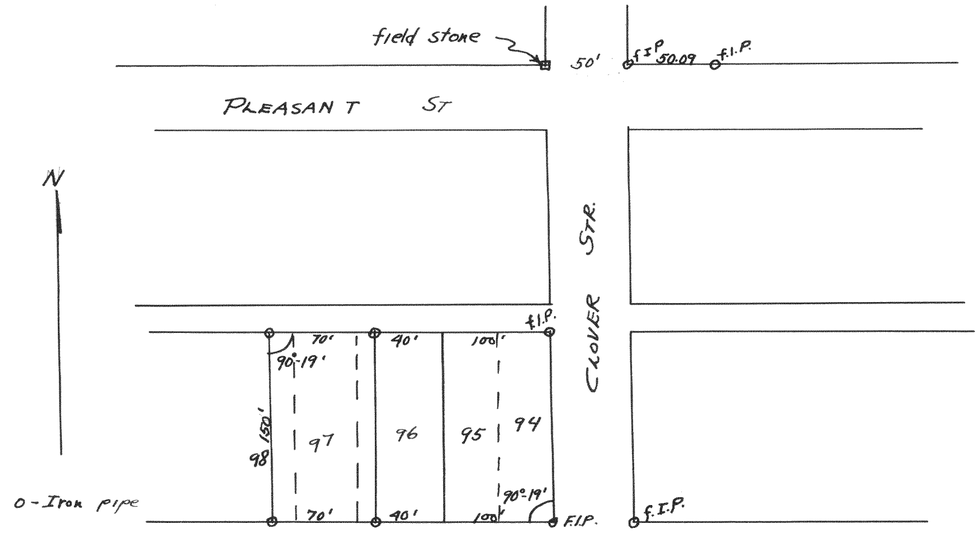

Plat of survey of lots 97 and part of lots 96 & 98 of Columbian Subd. located in the City of Lake Geneva. Wal Co. Wis.

April 1946 Lloyd L. Lemm Co Sur.

#1683

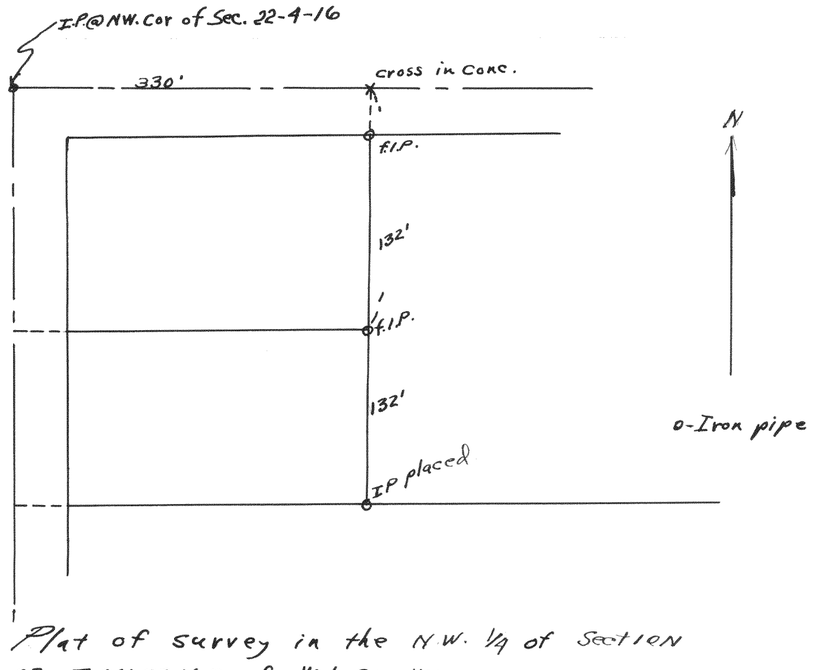

Plat of survey in the N.W. 1/4 of Section 22, T4NR16E of Wal Co. Wis

May 6, 1946 Lloyd L. Lemm Co Sur.