#1682

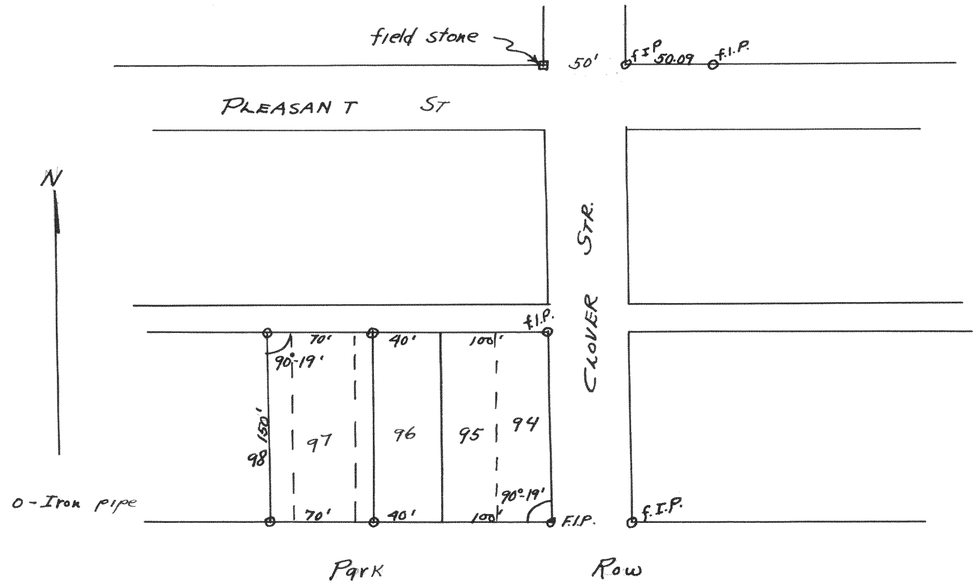


Plat of survey of lots 97 and part of lots 96 & 98 of Collumbian Subd. located in the City of Lake Geneva. Wal Co. Wis.

April 1946 Lloyd L. Jensen Co Sur.

#1683

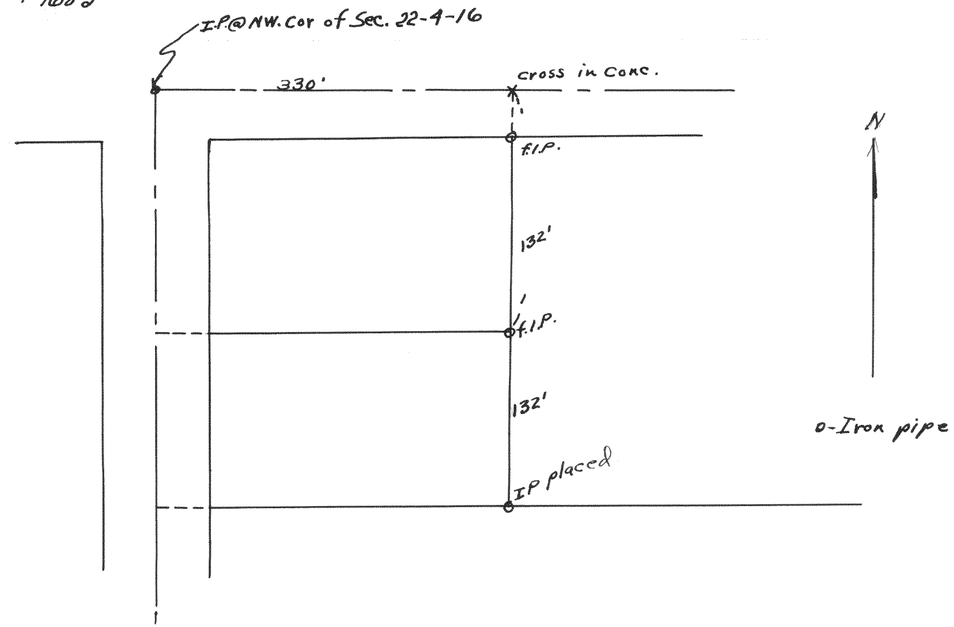


Plat of survey in the N.W. 1/4 of Section 22, T4NR16E of Wal Co. Wis.

May 6, 1946 Lloyd L. Jensen Co Sur.