
#1687

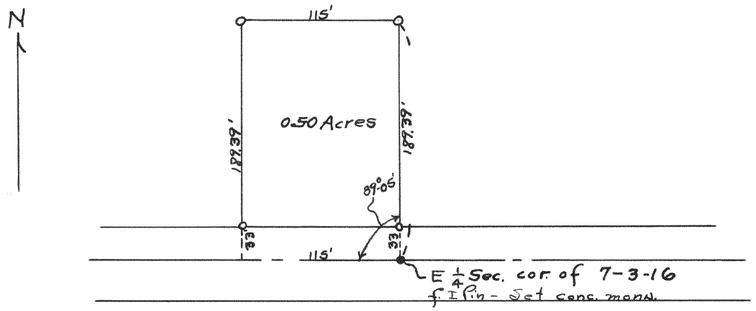


Plat of a survey of a parcel of land located in the Southeast ¼ of Section 7, T 3 N R 16 E of Walworth County Wisconsin. Used Subd. stakes for N-S line for E. Ln. of Section and the centerline of the road as fenced ± mile West for East-west line.

May 6, 1946

Lloyd L. Jensen
County Surveyor

#1688

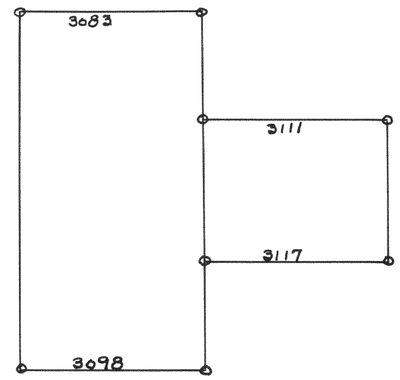

Survey of lots at Lake Como Beach Subdivision in T 2 N R 17 E of Walworth County Wisconsin.

May 11, 1946

Lloyd L. Jensen
County Surveyor