
#1691.

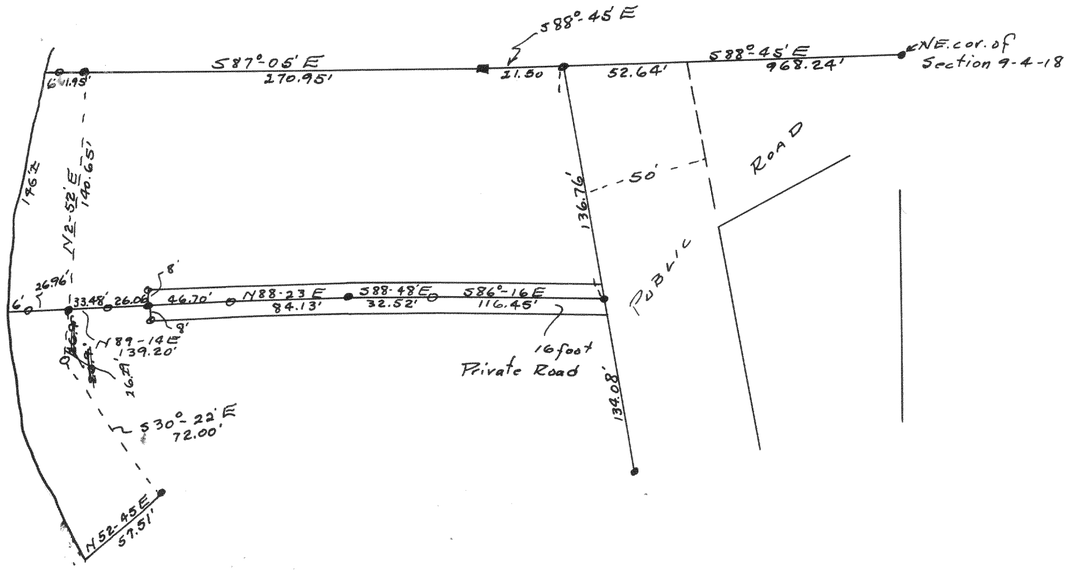


Plat of survey of the north part of the land owned by Mrs. Lippert in Section 9, T4N R18E of Walworth County Wisconsin.

See survey 1392 for South part of land.

Sept. 1946

Lloyd L. Jensen
County Surveyor

#1692

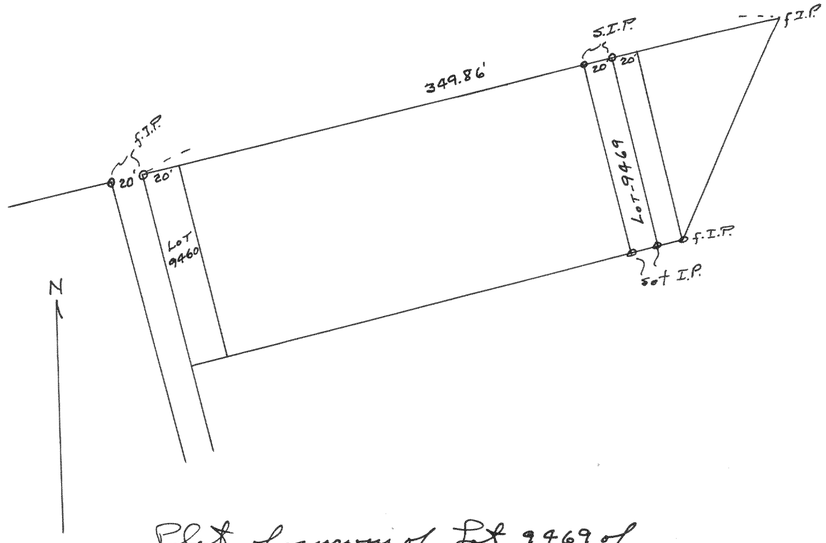

Plat of survey of Lot 9469 of Peel Lake Subd.

June 1946

Lloyd L. Jensen
County Surveyor