

#1695.

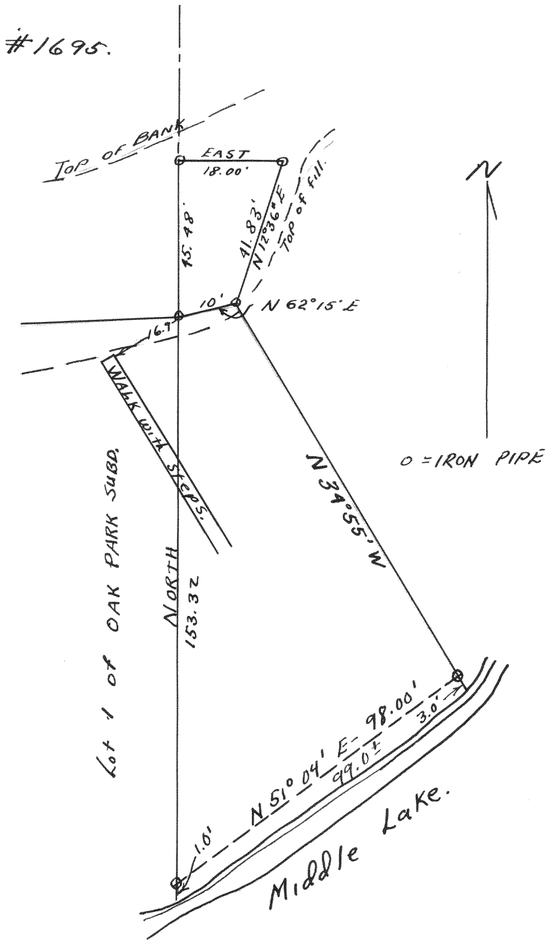


Plat of survey of land located in the East ½ of the SE ¼ of Sec 26 T 4 N R 16 E Wal Co. Wis.

Aug 17, 1946 Floyd L. Jensen Co Surv.

#1696.

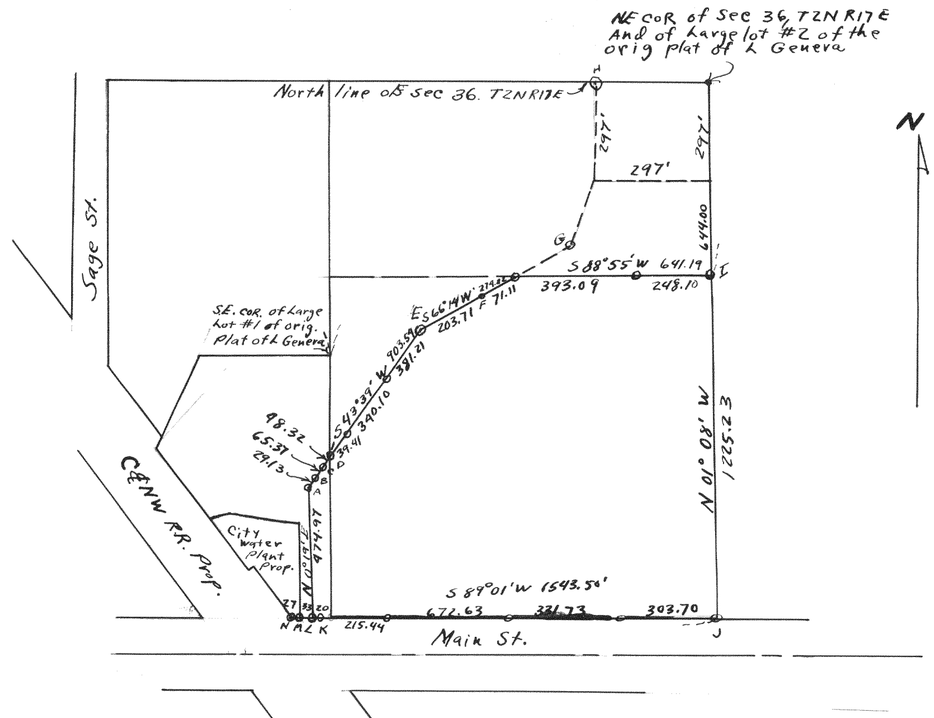


Plat of survey of part of large lot #2 & the "Reservation" of the original plat of Lake Geneva. The heavy line indicates the boundaries of land conveyed to Nathan Shure By a Sheriffs deed dated June 25 1927 and recorded on page 470 of Vol 194 of Deeds of Wal. Co., Wis. Iron stakes were found at points A - N inclusive.

Feb 10, 1947 Floyd L. Jensen Co Surv.