
#1705

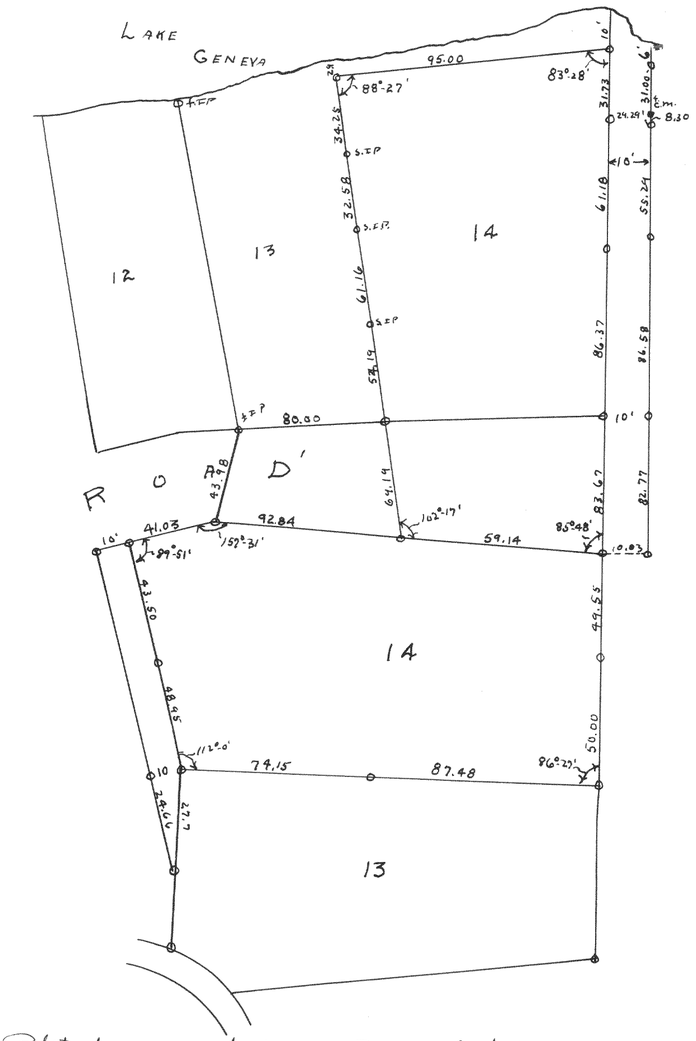


Plat of survey of LOT 14 BLK 3 and of LOT 14 BLK 1 Woodale Subdivision, south of Lake Geneva Walworth County Wisconsin

September 8, 1947

Lloyd T. Jensen
County Surveyor

#1706

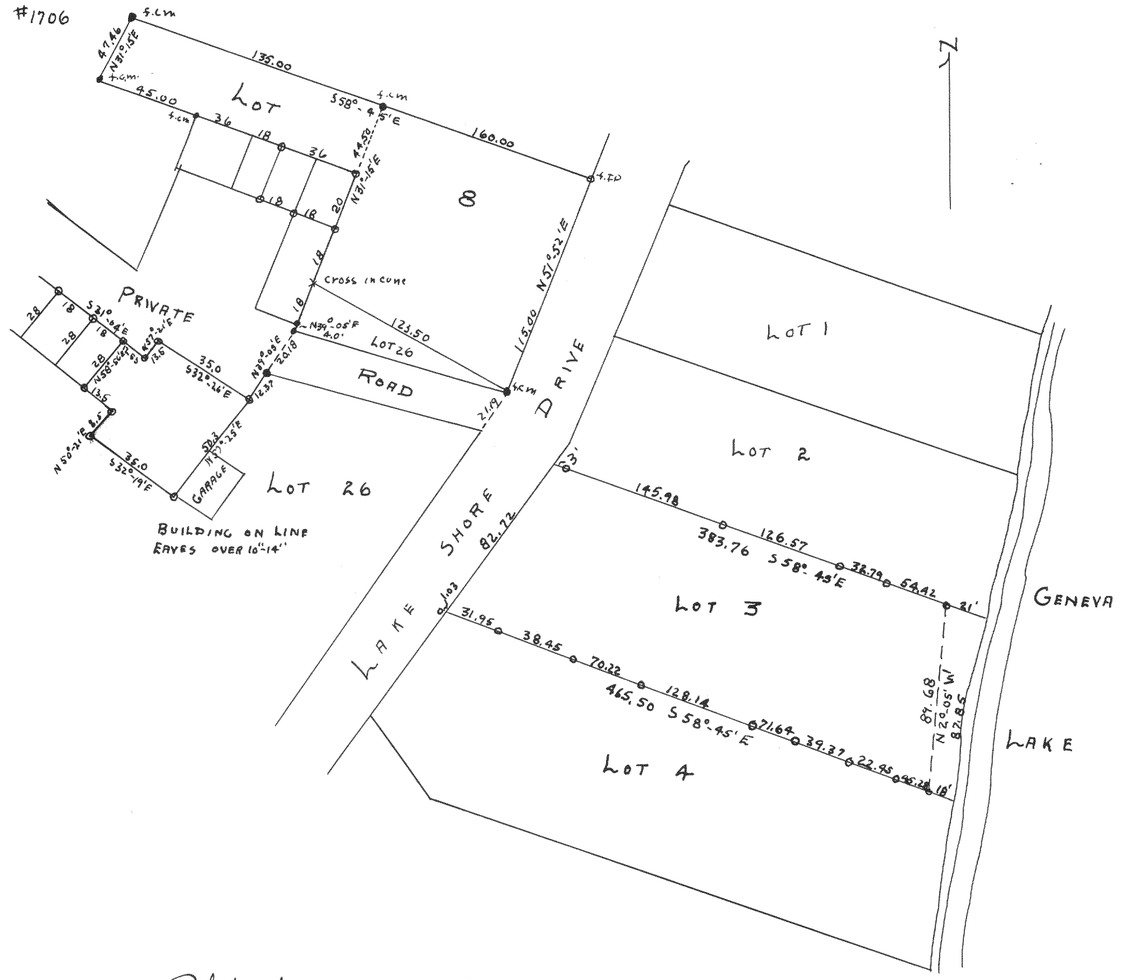

Plat of survey of Lots 3, 8, and part of 26 in The Gardens located in Fontana - Walworth County Wisconsin

October 1947

Lloyd T. Jensen
County Surveyor