
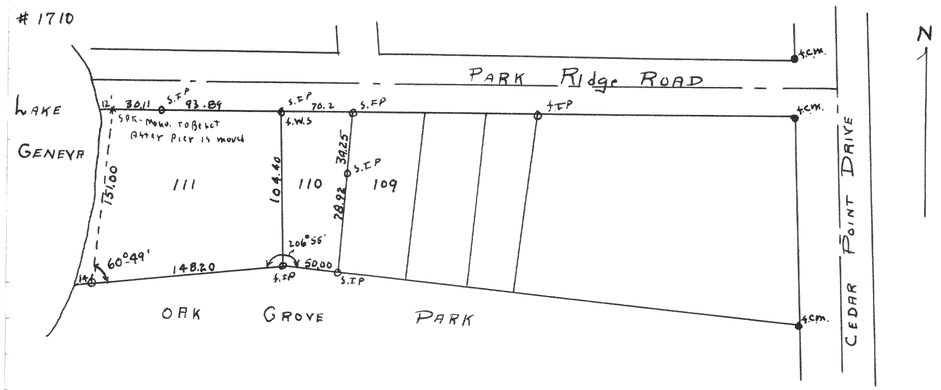


Plat of survey of Lots 110 and 111 in Cedar Point Park 2nd addition in Williams Bay Walworth County Wisconsin

October 30, 1947

Lloyd L. Jensen
County Surveyor

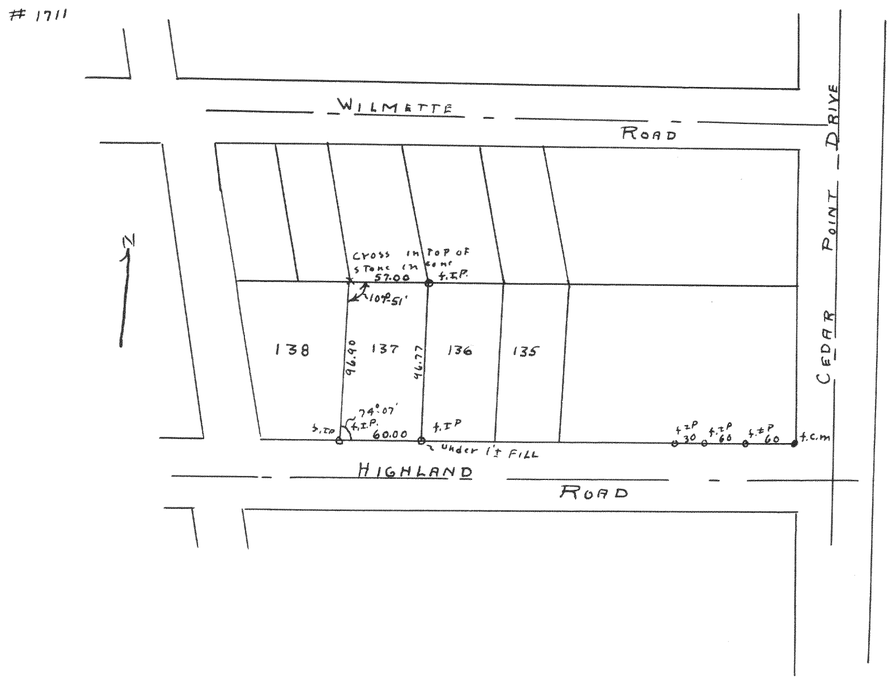

Plat of survey of Lot 137 Cedar Point Park 2nd Addition located in Williams Bay Walworth County Wisconsin

Oct 31, 1947

Lloyd L. Jensen
County Surveyor