#1712

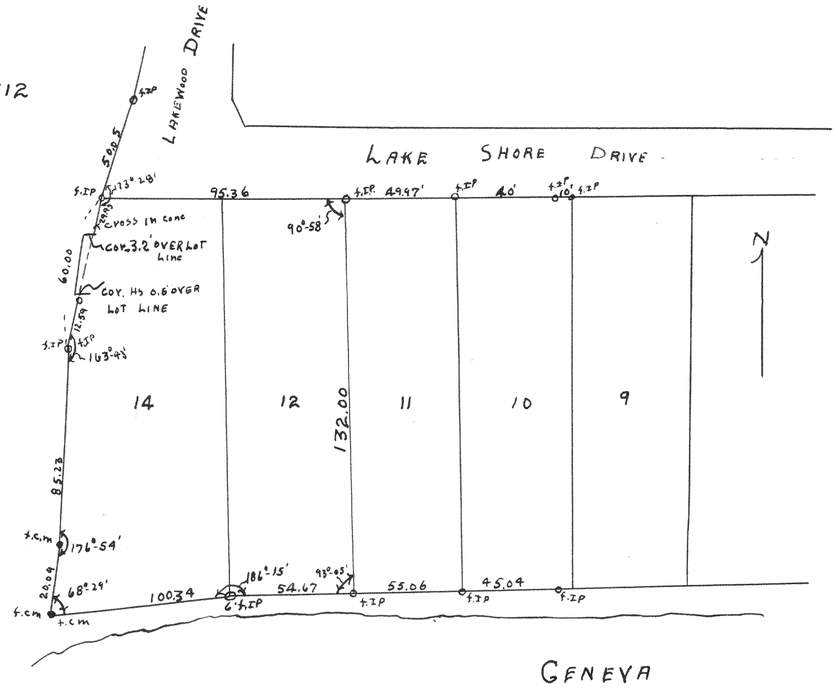

Plat of survey of Lots 12 and 14 of Block 18 located in Lake Geneva Manor, Walworth County Wisconsin

November 17, 1949

Lloyd L. Jensen
County Surveyor

#1713

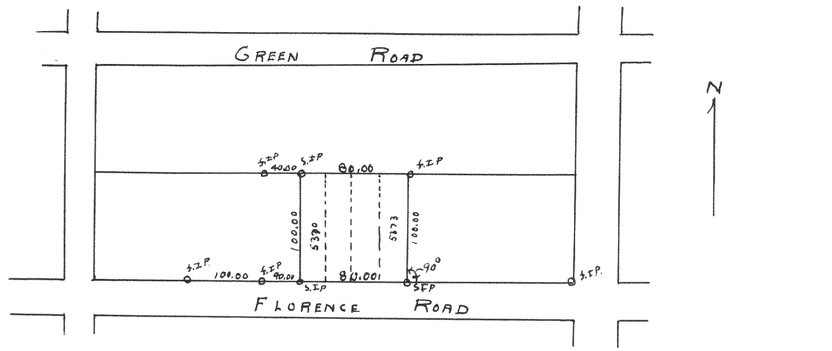

Plat of survey of Lots 5370 - 5373 Section 3 of Bell Lake Subdivision Walworth County Wisconsin

November 17, 1949

Lloyd L. Jensen
County Surveyor

#1714

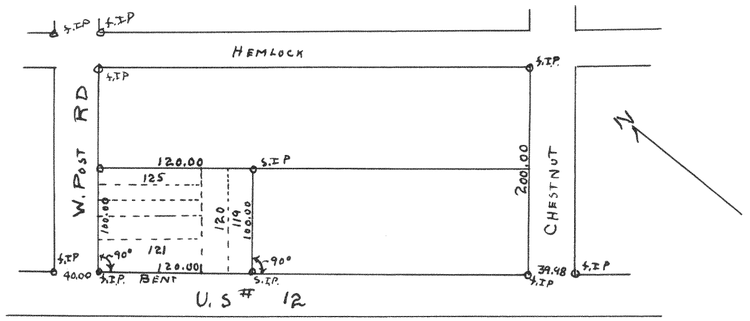

Plat of survey of lots 119 - 125 of Section I of Bell Lake Walworth County, Wisconsin

November 17, 1949

Lloyd L. Jensen
County Surveyor