
#1715

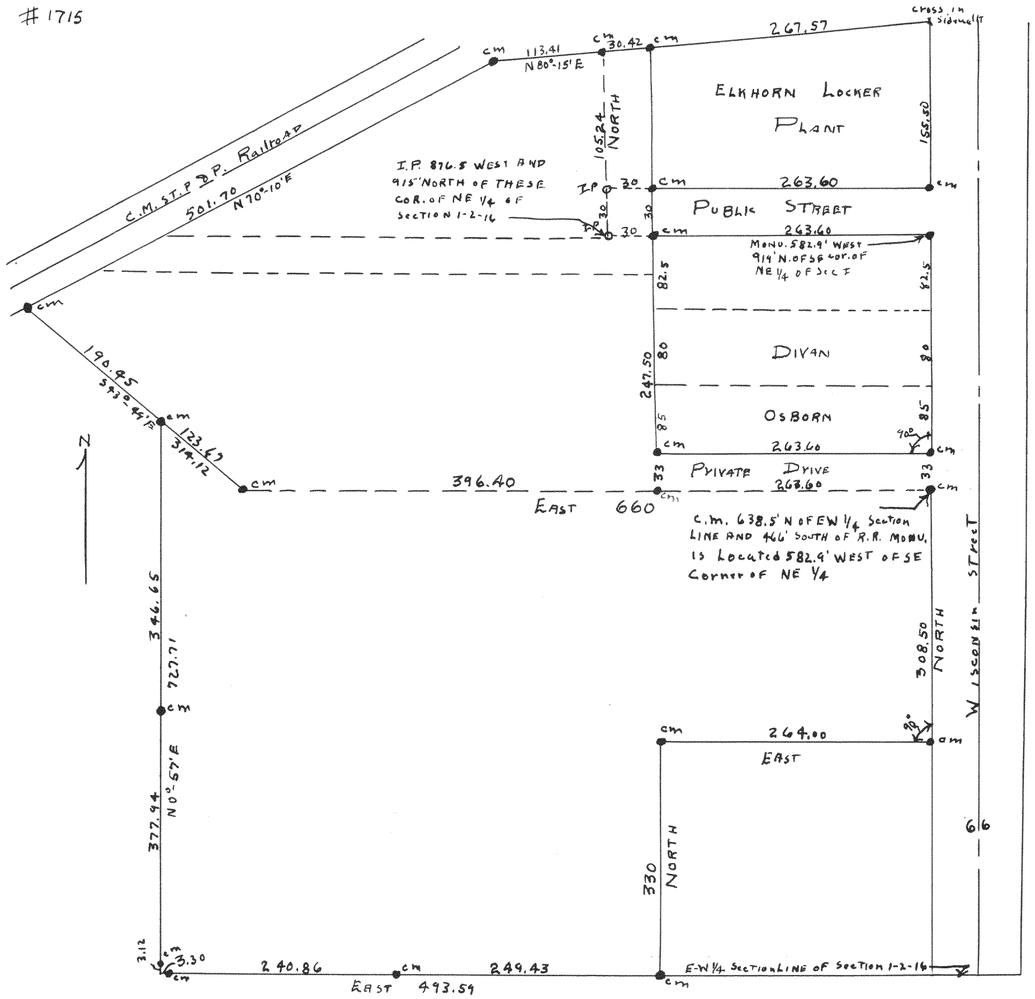


Plat of survey of land owned by The Elkhorn Canning Company located in the City of Elkhorn, Walworth county, Wisconsin

NOV. 17, 1947

Lloyd S. Jensen
County Surveyor

#1716

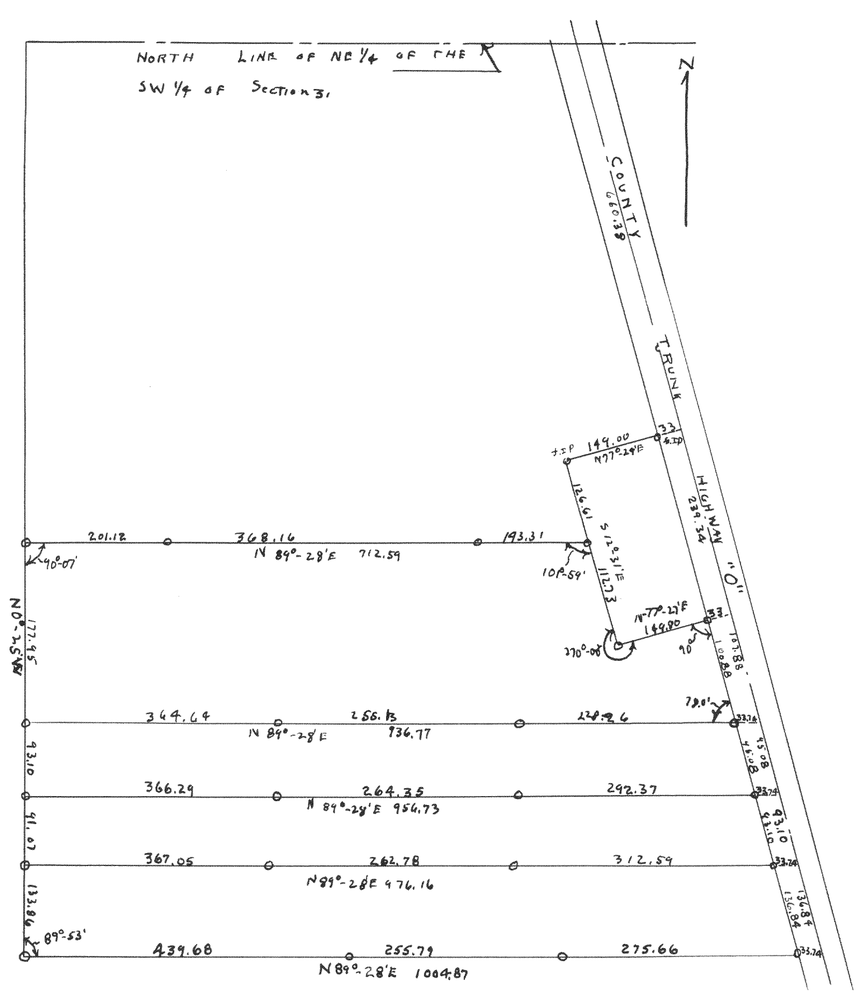

Plat of survey on the Drechsler Property located in Section 31, T2N. R.16E of Walworth county, Wisconsin

Aug. 1947

Lloyd S. Jensen
County Surveyor