
1721

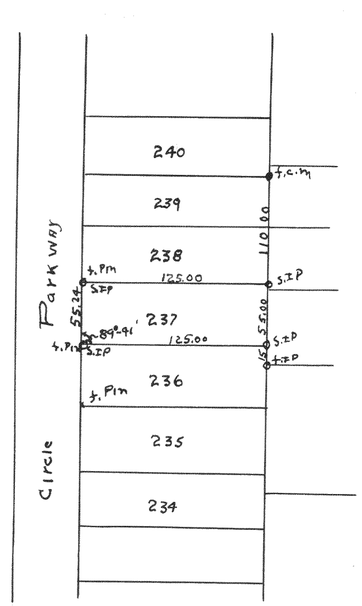


Plat of survey of Lot 237 in Cedar Point Park 3rd Addition in Village of Williams Bay, Walworth County Wisconsin

Nov. 3, 1947

Lloyd L Jensen
County Surveyor

1722

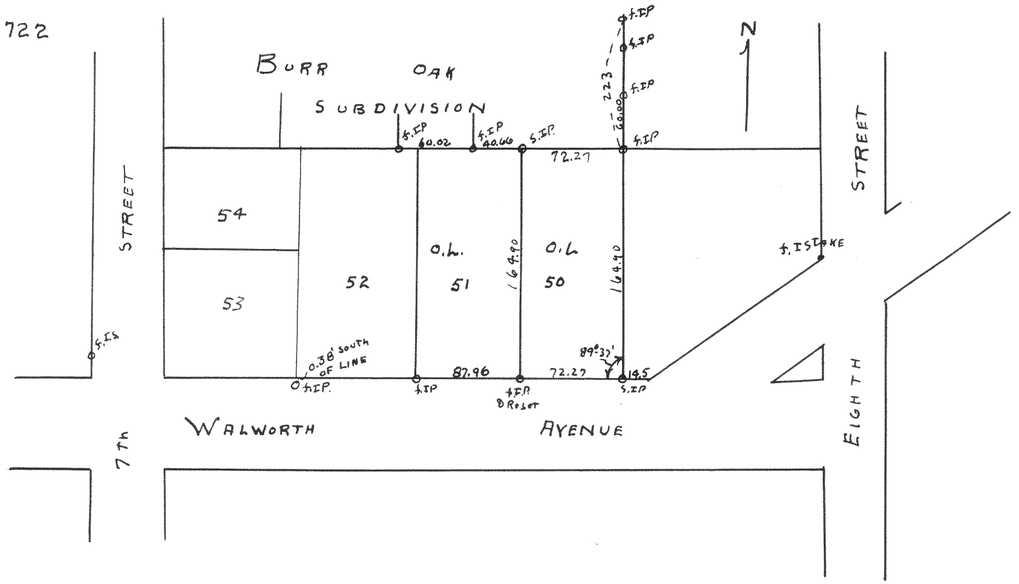

Plat of survey of O.L. 50 of assessors Plat City of Delavan Walworth County Wisconsin

1947

Lloyd L Jensen
County Surveyor