
1723

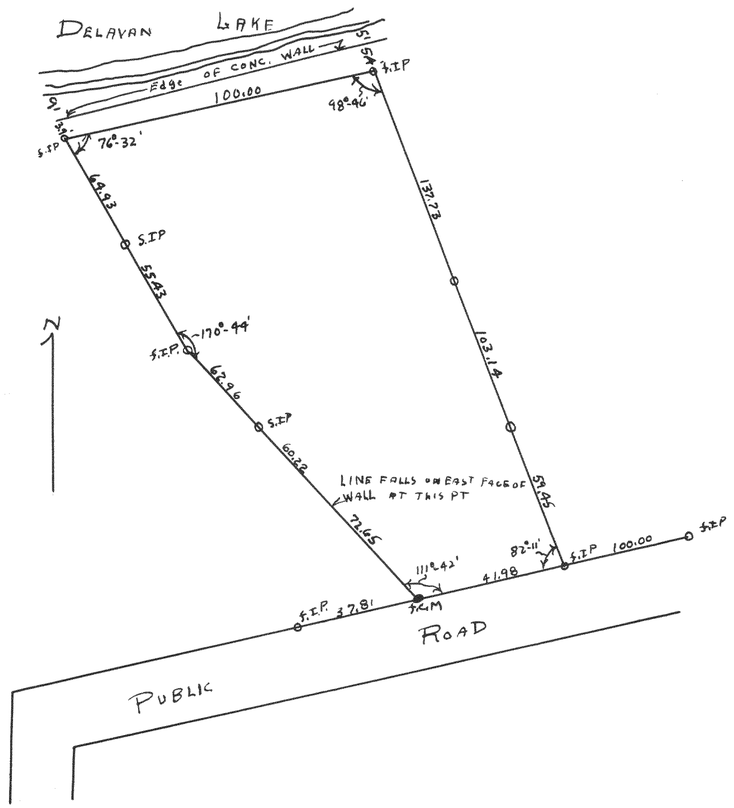


Plat of survey of parts of Lots 1 and 2 of Plat of Sans Souci, section 27-T2N-R16E of Walworth County, Wisconsin

NOV 1947

Lloyd S Jensen
County Surveyor

1724

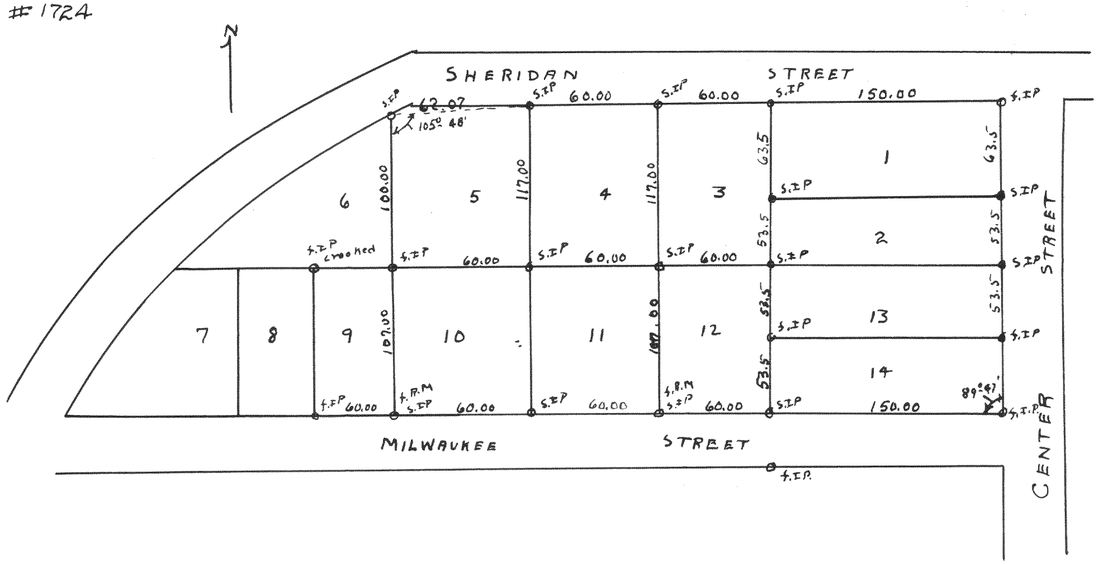

Plat of survey of Lots 1-9, 10-14 in Warhurst subdivision in city of Lake Geneva, Walworth County, Wisconsin

December 5, 1947

Lloyd S Jensen
County Surveyor