
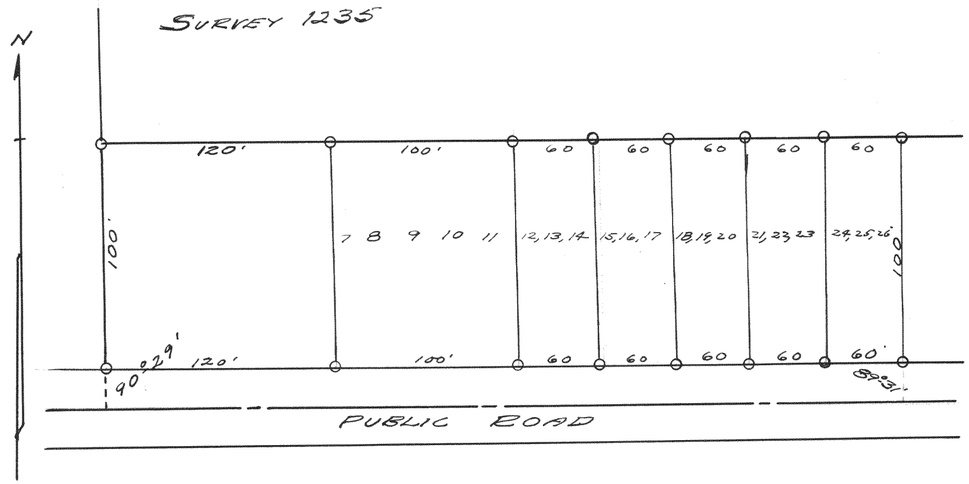


PLAT OF SURVEY OF LOTS 7 TO 26 INC. OF PELL FARM ANNEX
AUG. 1941

Lloyd L. Jensen
R.E.J.

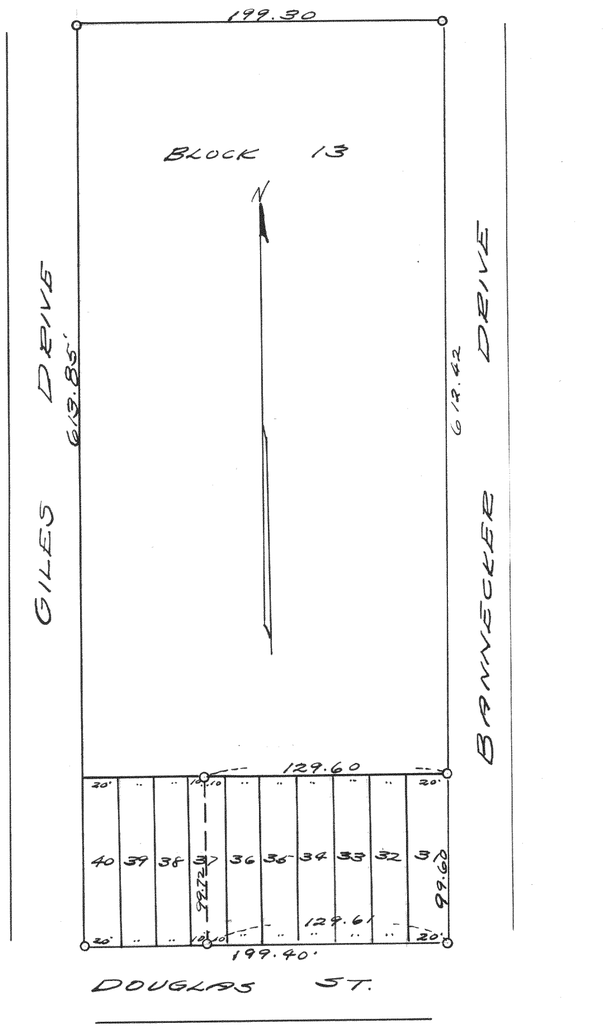

PLAT OF SURVEY OF LOTS 31 TO 36 OF BLOCK 13, OF LAKE IVANHOE SUBD., WALWORTH COUNTY, WISCONSIN.
APRIL, 1941

Lloyd L Jensen
R.E.J.