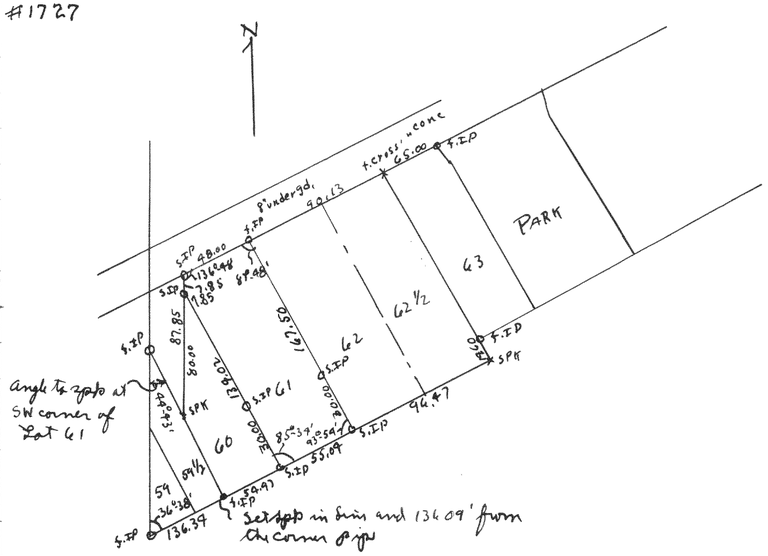
#1727


N
f.cross'n conc
65.00
F.I.P
S.I.P
8' underg'd
99.43
PARK
63
62½
62
61
60
59
S.I.P 48.00
136.48
87.98
87.85
S.I.P
S.I.P
S.I.P