
#1729

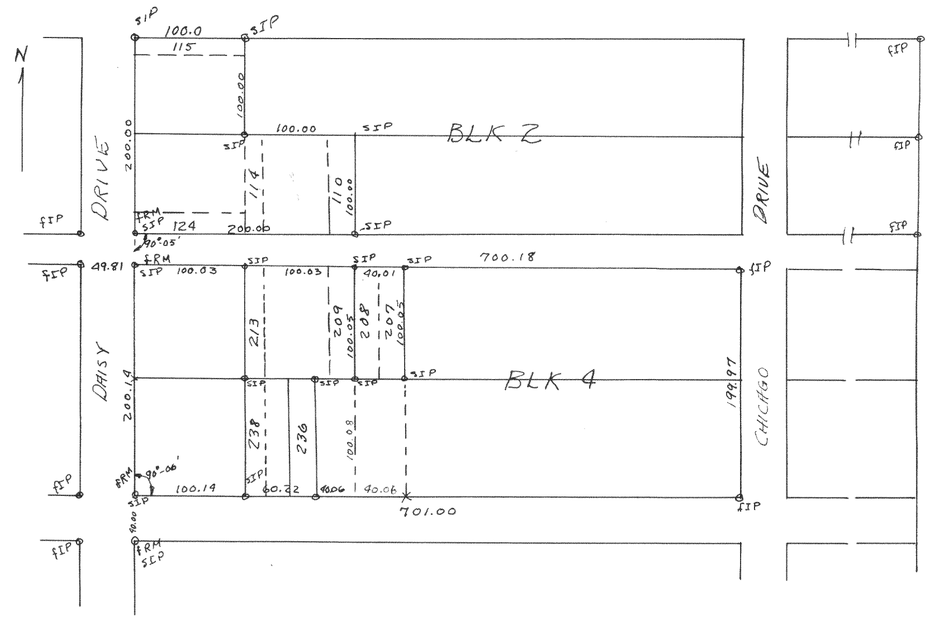


Plat of survey of lots 110-124, 207-213, 236-238 in Dell Lake Addition Walworth County, Wisconsin

April 2, 1997

Lloyd L. Jensen
County Surveyor

#1730

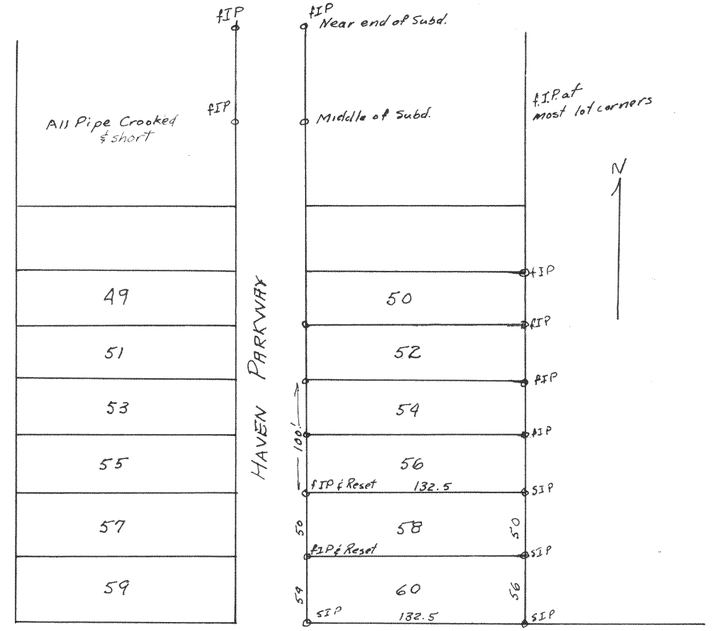

Plat of survey of Lots 58 & 60 in Shore Haven subdivision in section 18 T1N R17E of Walworth County Wisconsin

April 11, 1997

Lloyd L Jensen
County Surveyor