
#1731

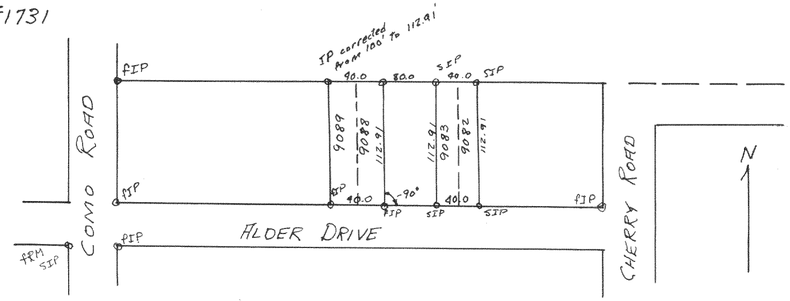


Plat of survey of Lots 9082-9083 of 4th Map Lake Como Beach Subdivision, Walworth County Wisconsin

1947

Lloyd S Jensen
County Surveyor

#1732

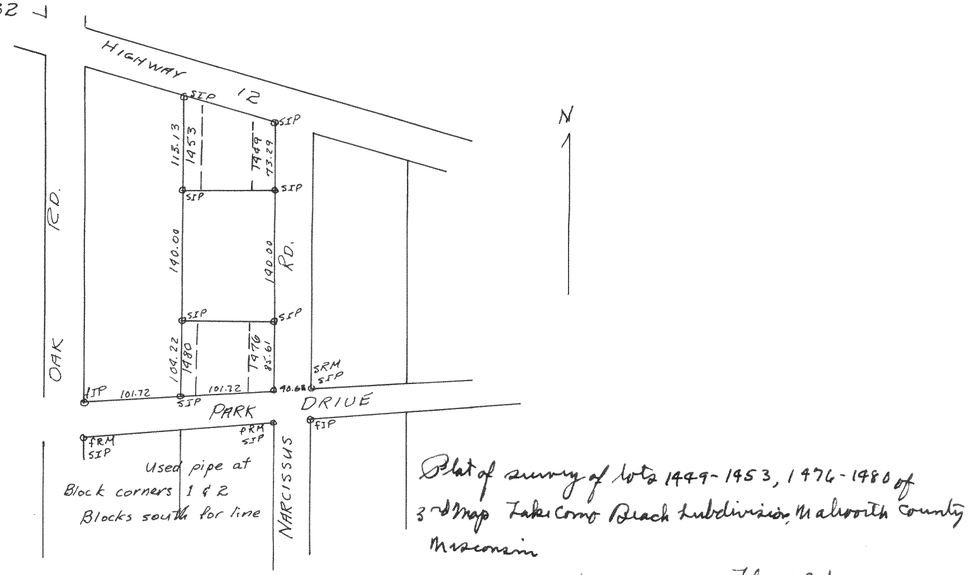


Plat of survey of lots 1449-1453, 1476-1480 of 3rd Map Lake Como Beach Subdivision, Walworth County Wisconsin

1947

Lloyd S Jensen
County Surveyor

#1733

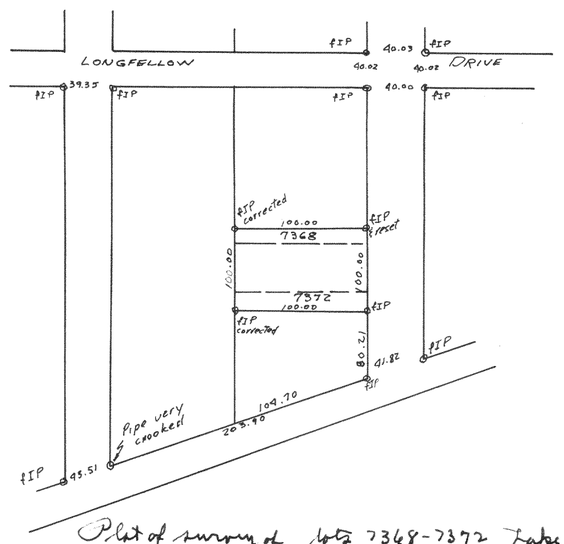


Plat of survey of lots 7368-7372 Lake Como Beach Subdivision Walworth County Wisconsin

April 14, 1947

Lloyd S Jensen
County Surveyor

#1734

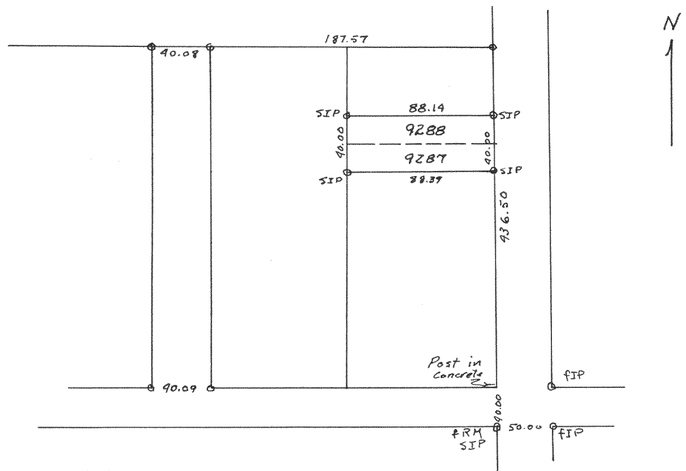

Lots 9287-9288 Lake Como Beach Subdivision in Walworth County Wisconsin

April 14, 1947

Lloyd S Jensen
County Surveyor