
#1738

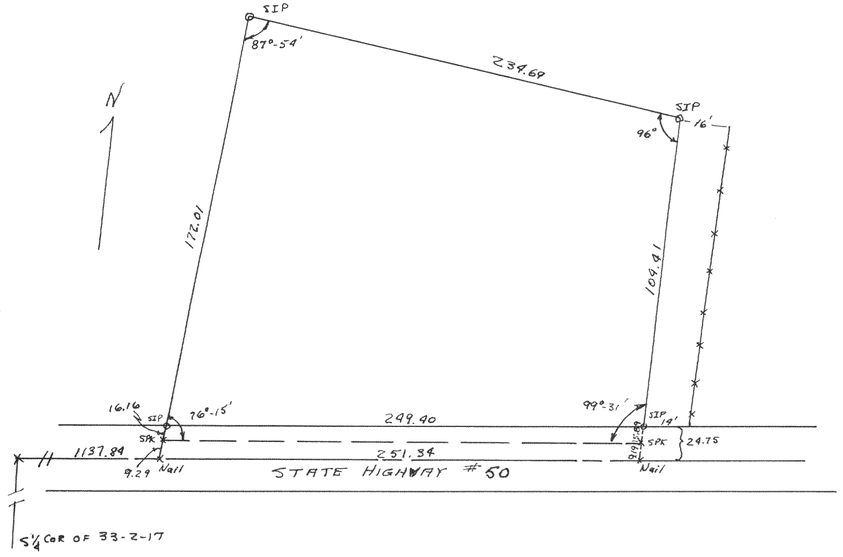


Plat of survey of parcel of land on the Chapin 7 acres located in Section 33 T 2N R 17E of Walworth County, Wisconsin

April 14 1947

Lloyd S Jensen
County Surveyor

#1739

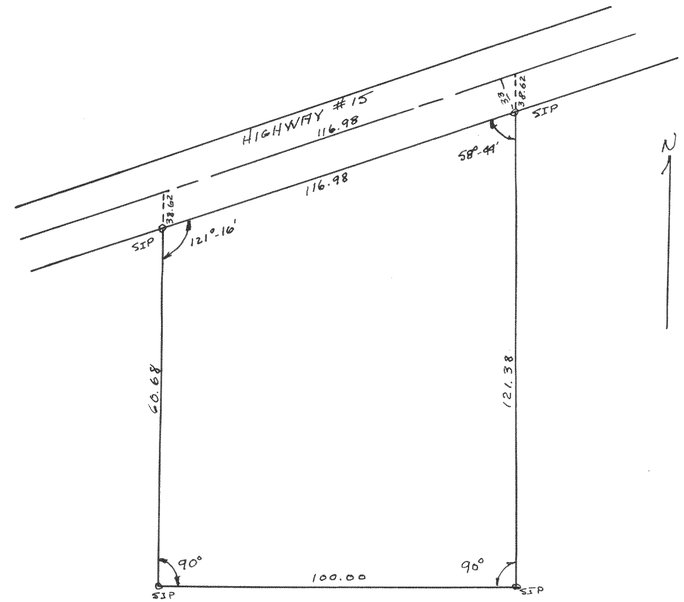

Plat of survey of parcel of land bought by the Wisconsin Lee and Coal company, located in Section 20 T 4N R 18E of Walworth County, Wisconsin

April 1947

Lloyd S Jensen
County Surveyor