
#1740

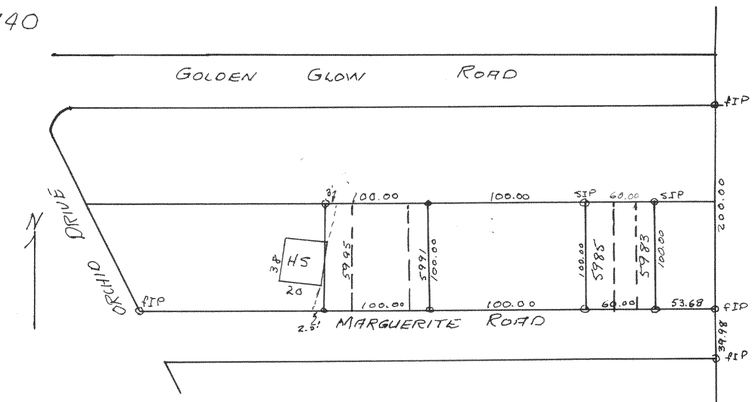


Plat of survey of lots 5982-5985, 5991-5995 in Bell Lake Subdivision Walworth County Wisconsin

April 26, 1947

Floyd S Jensen
County Surveyor

#1741

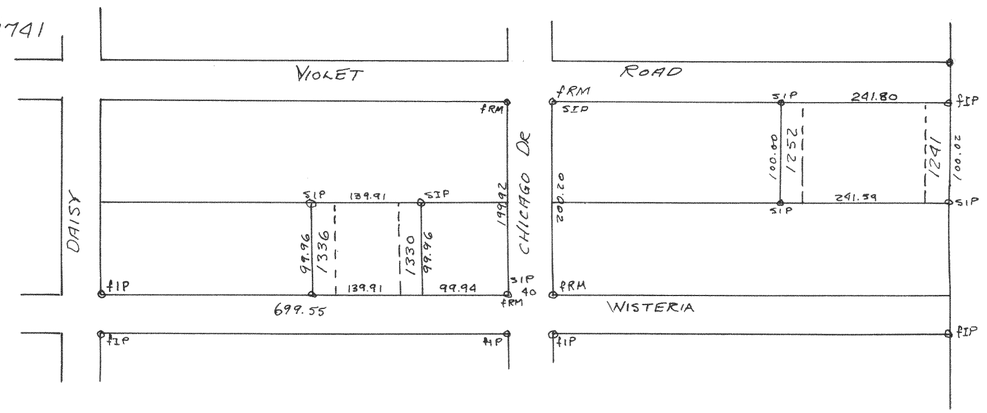


Plat of survey of lots 1241-1252, 1330-1336 Bell Lake Addition Walworth County, Wisconsin

April 26, 1947

Floyd S Jensen
County Surveyor

#1742

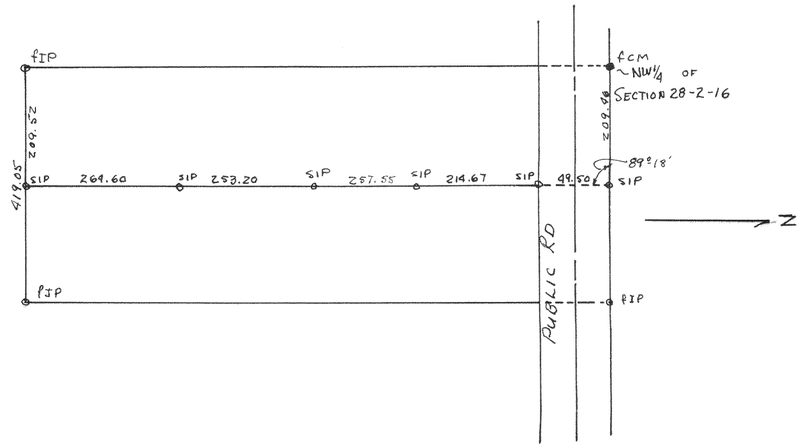



1947

Floyd S Jensen
County Surveyor

#1743

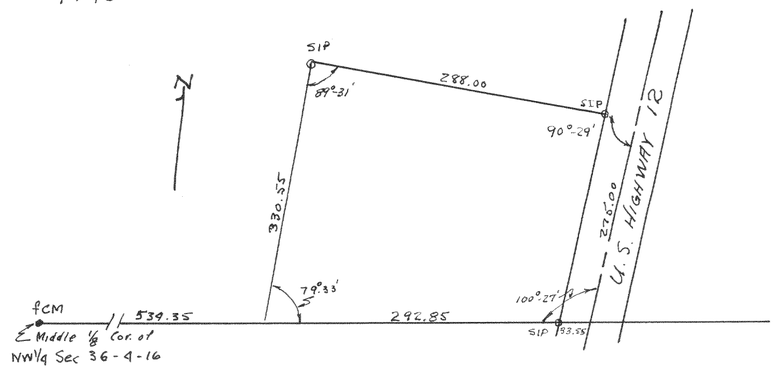

Plat of survey of parcel of land on the Swanson Farm Lauderdale Lake located in the NW 1/4 of Section 36-T4NR16E of Walworth County Wisconsin

May 15, 1947

Floyd S Jensen
County Surveyor