
#1749

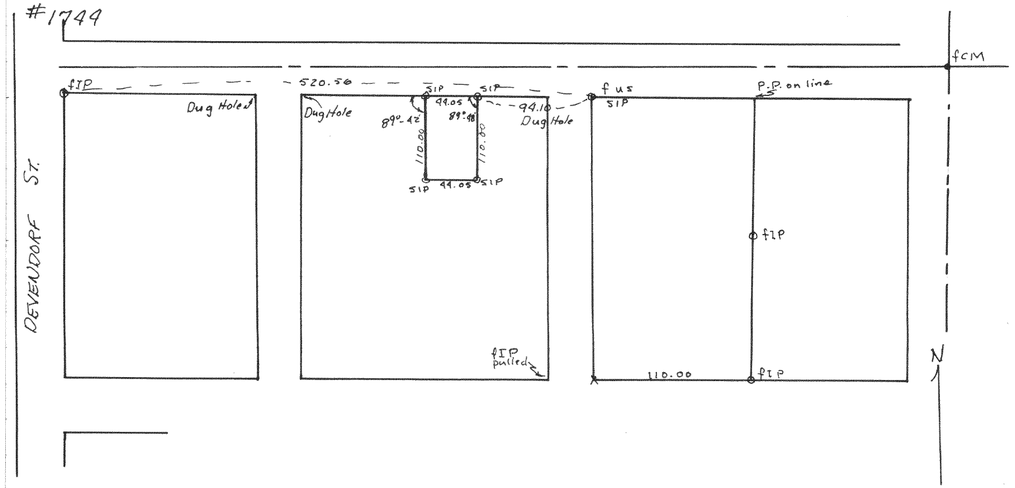


Plat of survey of Lots 304 of Elkhorn Gardens, City of Elkhorn Walworth County Wisconsin

May 14, 1997

Lloyd S Jensen
County Surveyor

#1745

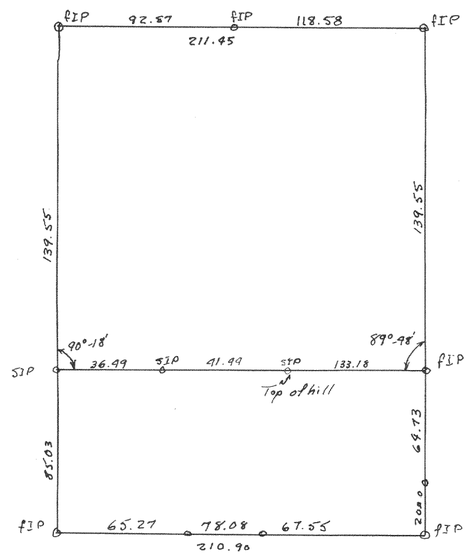

Plat of survey of the north 139.55' of Lot 34 in Lockwoods subdivision, Walworth County, Wisconsin

May 21, 1997

Lloyd S Jensen
County Surveyor