
#1746

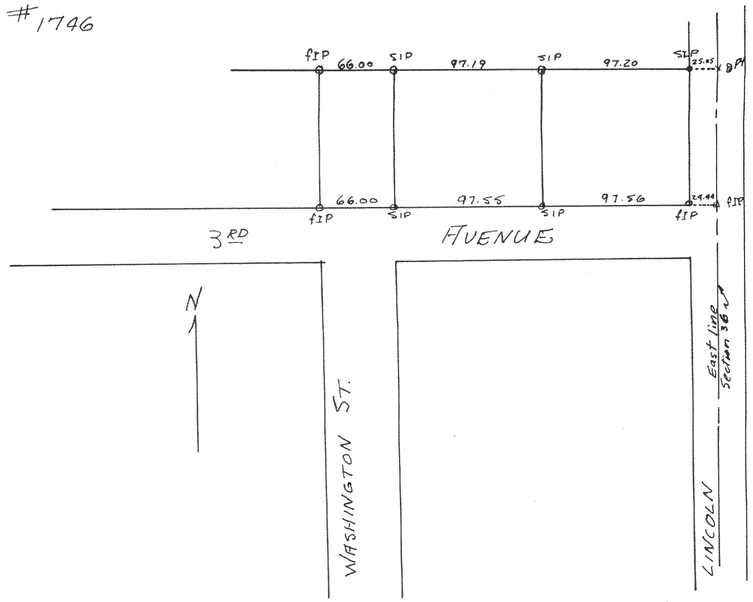



Plat of survey of campbell property located in the City of Elkhorn, Walworth county Wisconsin

May 21, 1947

Lloyd S Jensen
County Surveyor

#1747

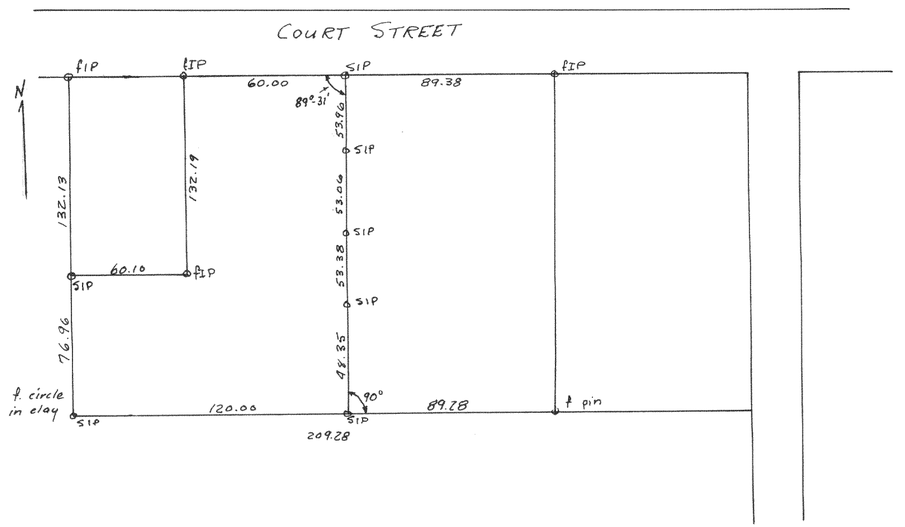


Plat of survey of parcel of land sold to McInnis by Tubbs located in the City of Elkhorn, Walworth County, Wisconsin

May 23, 1947

Lloyd S Jensen
County Surveyor