
#1748

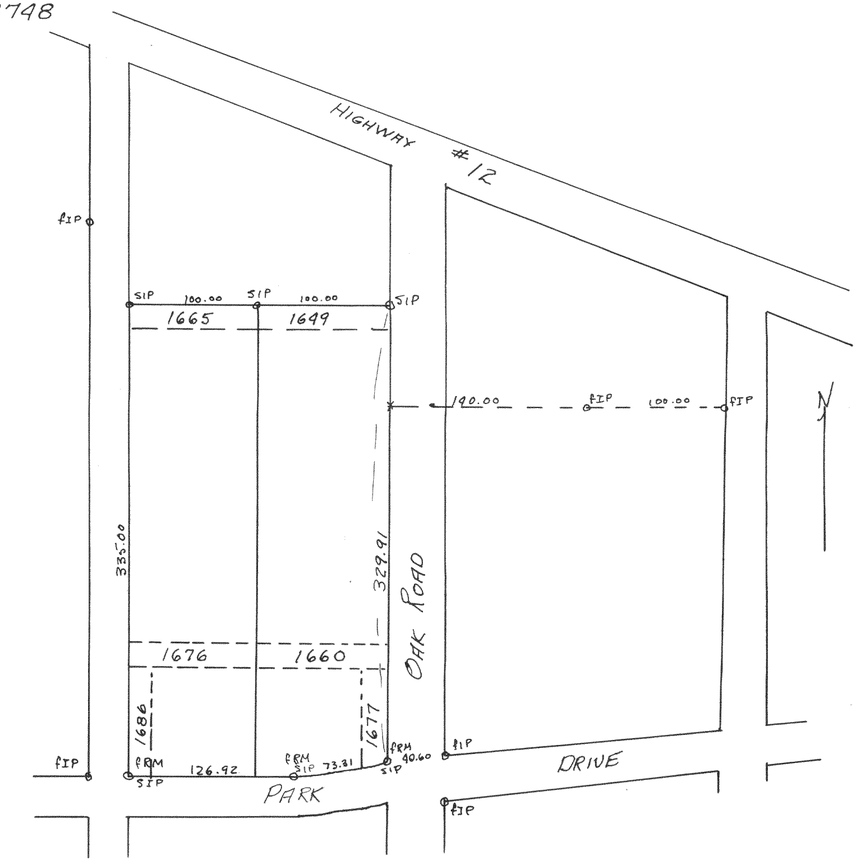


Plat of survey of lots 1649-1660, 1665-1686 Lake Como Beach subdivision, Walworth County Wisconsin

May 24, 1947

Floyd S Jensen
County Surveyor

#1749

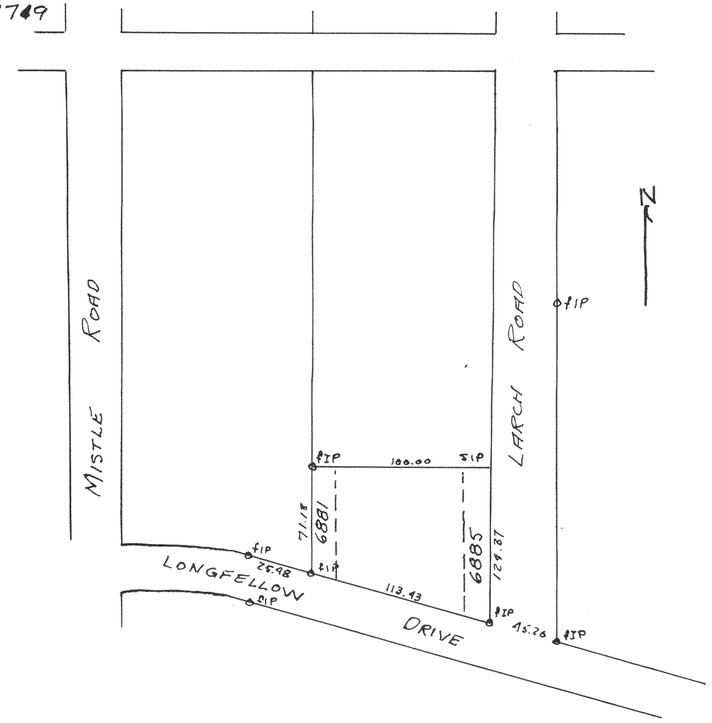

Plat of survey of lots 6881-6885 Lake Como Beach subdivision Walworth County Wisconsin

May 24, 1947

Floyd S Jensen
County Surveyor