#1750

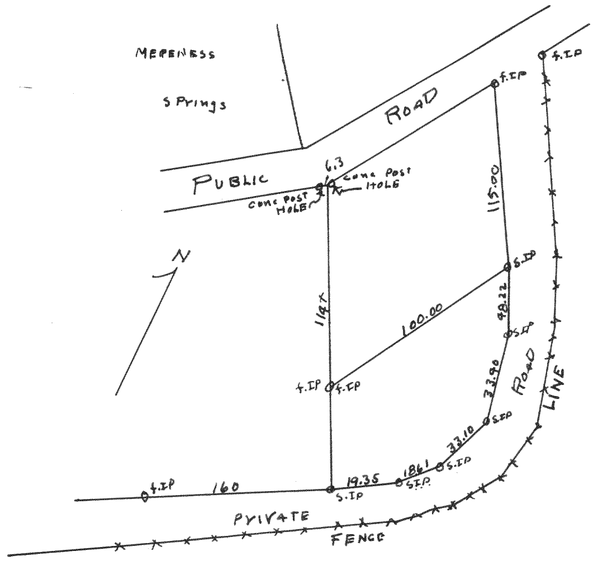

Plat of survey of a lot on the Al Blodgett Farm, S.E. of Merreness Springs subdivision in SW1/4 of Section 22 T2N R16E of Walworth County, Wisconsin

1947

Lloyd S Jensen
County Surveyor

#1751

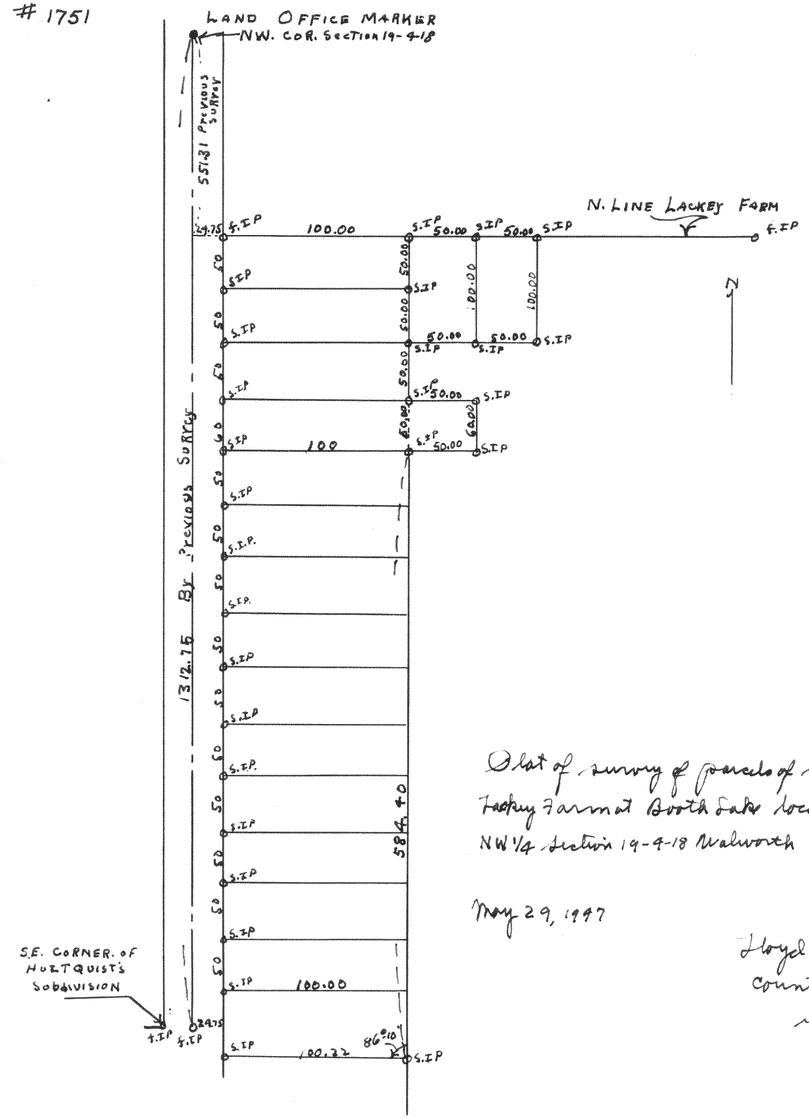

Plat of survey of parcels of land on the Joe Lackey Farm at Booth Lake located in the NW1/4 Section 19-4-18 Walworth County Wisconsin

May 29, 1947

Lloyd S Jensen
County Surveyor