
#1752

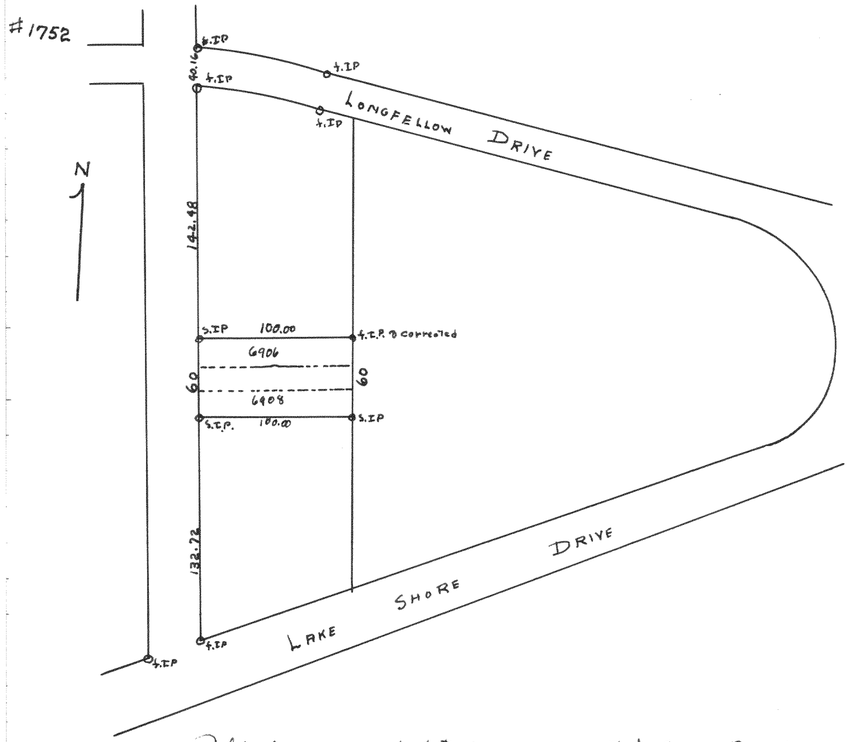


Plat of survey of lots 6906 - 6908 Lake Como Beach
Walworth County Wisconsin

June 13, 1947

Floyd S Jensen
County Surveyor
~~SSS~~

#1753

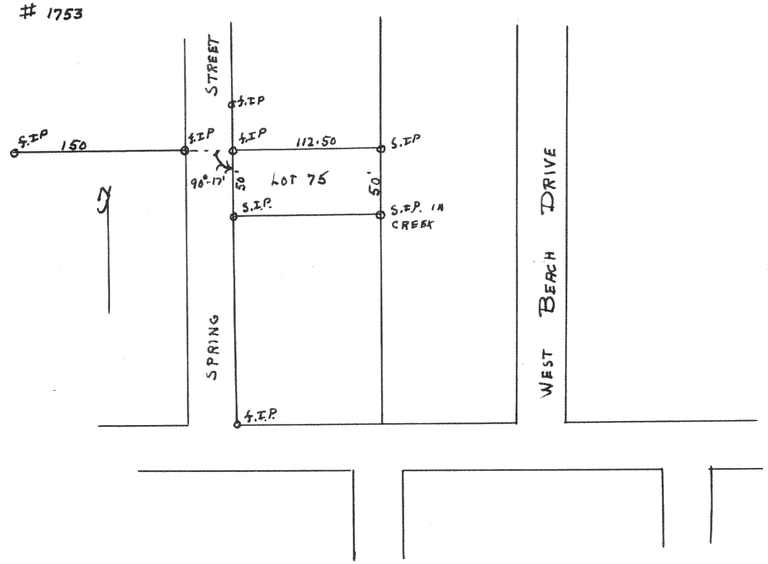

Plat of survey of Lot 75 Lake ~~Geneva~~ Como Beach Subdivision
Walworth County Wisconsin

July 5, 1947

Floyd S Jensen
County Surveyor
~~SSS~~