
1758

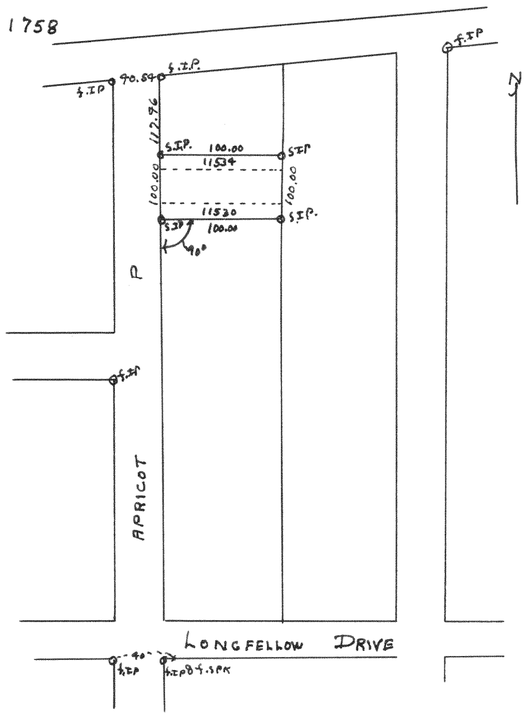


Plat of survey of lots 11530-11534 Lake Como Beach, Walworth County, Wisconsin

July 30 1947

Floyd L Jensen
County Surveyor

1759

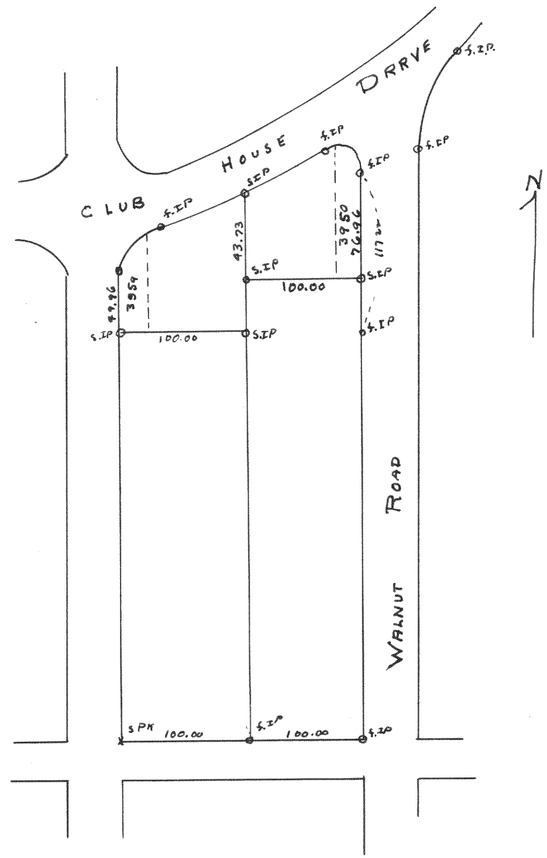

Plat of survey of lots 3950-3959 Lake Como Beach Walworth County, Wisconsin

July 30, 1947

Floyd L Jensen
County Surveyor