
#1760

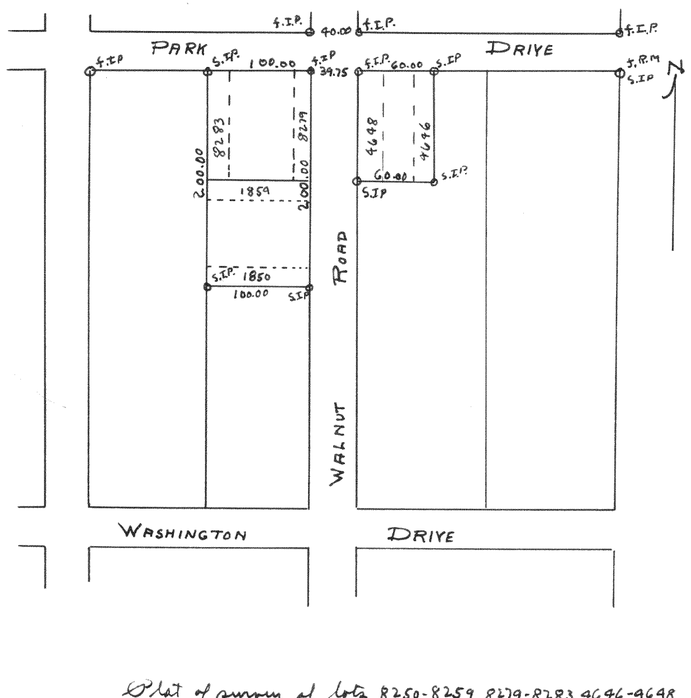


Plat of survey of lots 8250-8259, 8279-8283, 4696-9698
Lake Como Beach Walworth County Wisconsin

Aug 1, 1947

Floyd L. Jensen
County Surveyor

#1761

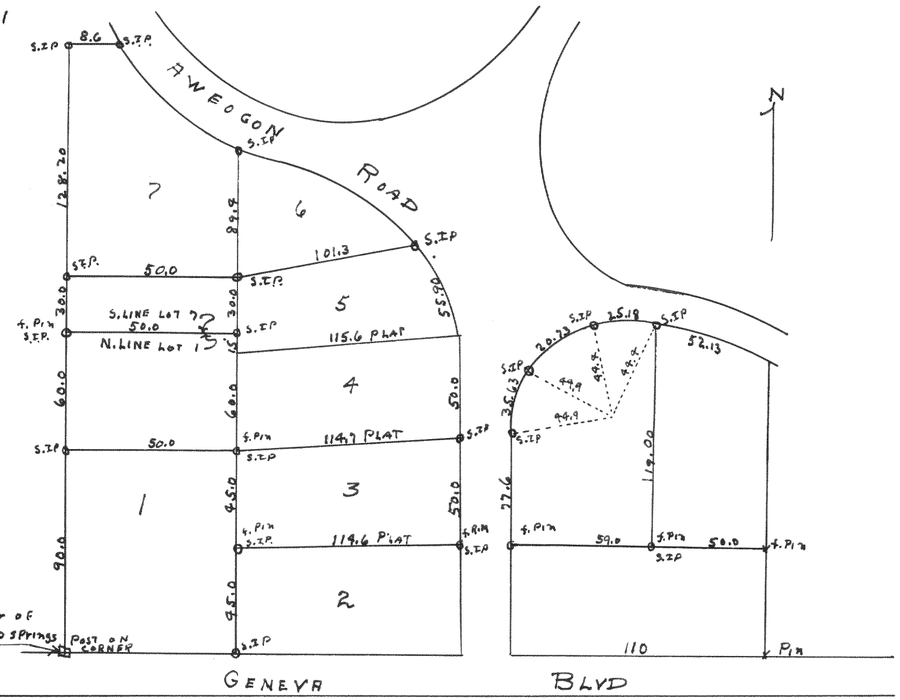

Plat of survey of lots 1, 4, 5, 7 Block 1 and Lot 1 of Block 4
Indian Hills Subdivision, Fontana, Walworth County, Wisconsin

Aug, 1947

Floyd L. Jensen
County Surveyor