#1764

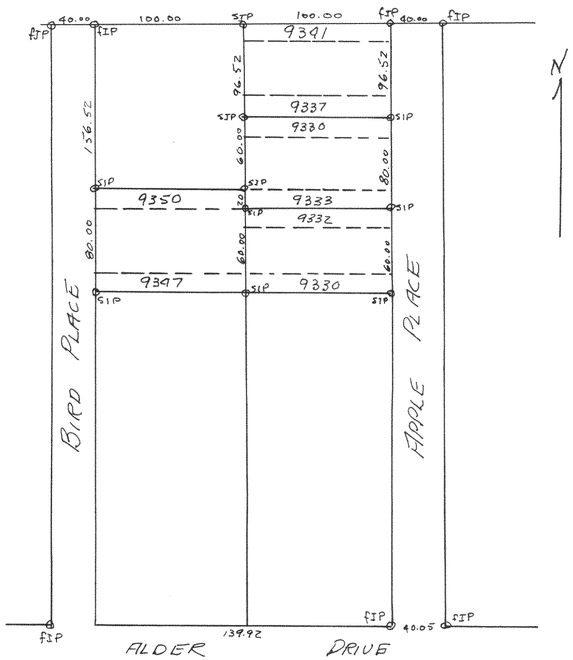

Plat of survey of lots 9347-9350, 9330-9332, 9333-9336, and 9337-9341 in Lake Como Beach Subdivision Walworth County, Wisconsin

Aug 22, 1947

Floyd S Jensen
County Surveyor

#1765

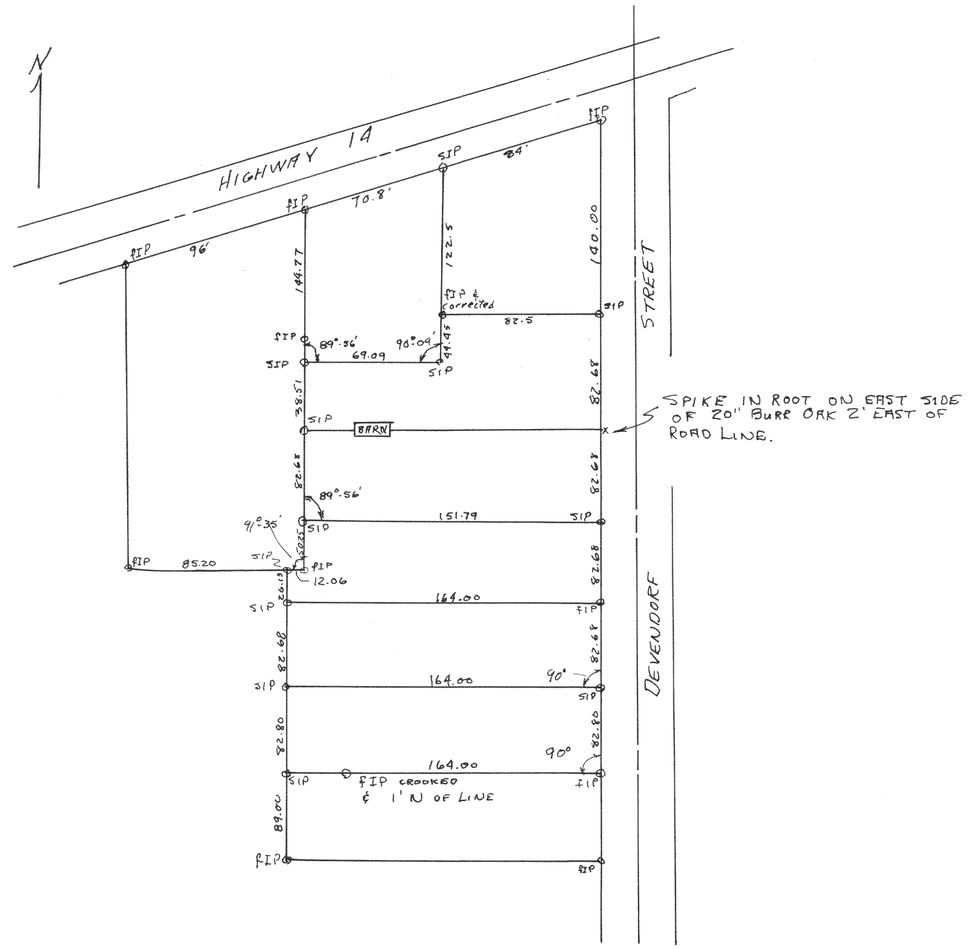

Plat of survey of land owned by Burpee on Devendorf St in the City of Elkhorn, Walworth County, Wisconsin

Aug 1947

Floyd S Jensen
County Surveyor