
#1766

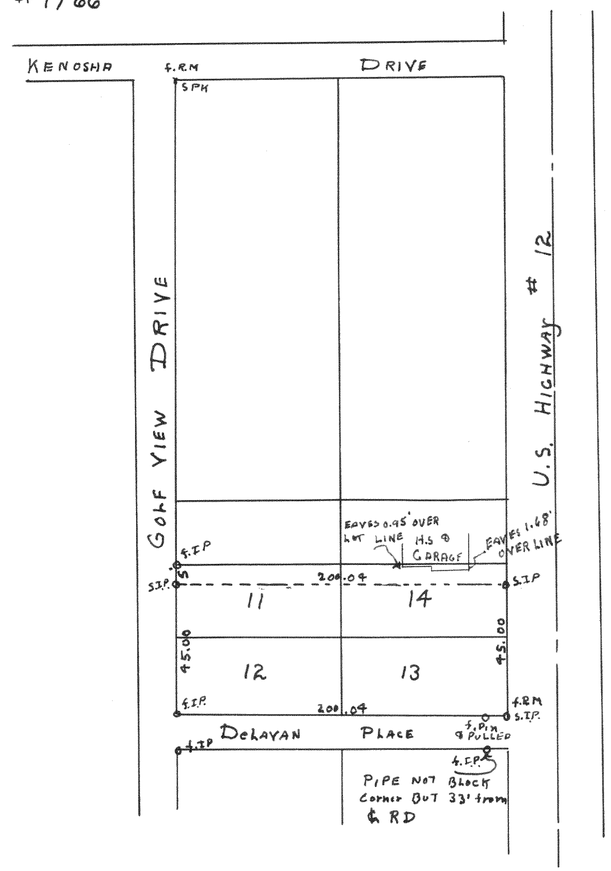


Plat of survey of Lots 12-13 and the south 45' of lots 11814 of Block 23 in Block 23 in Mandawega Subdivision, Walworth County Wisconsin

Nov 20, 47

Lloyd L. Jensen
County Surveyor

#1767

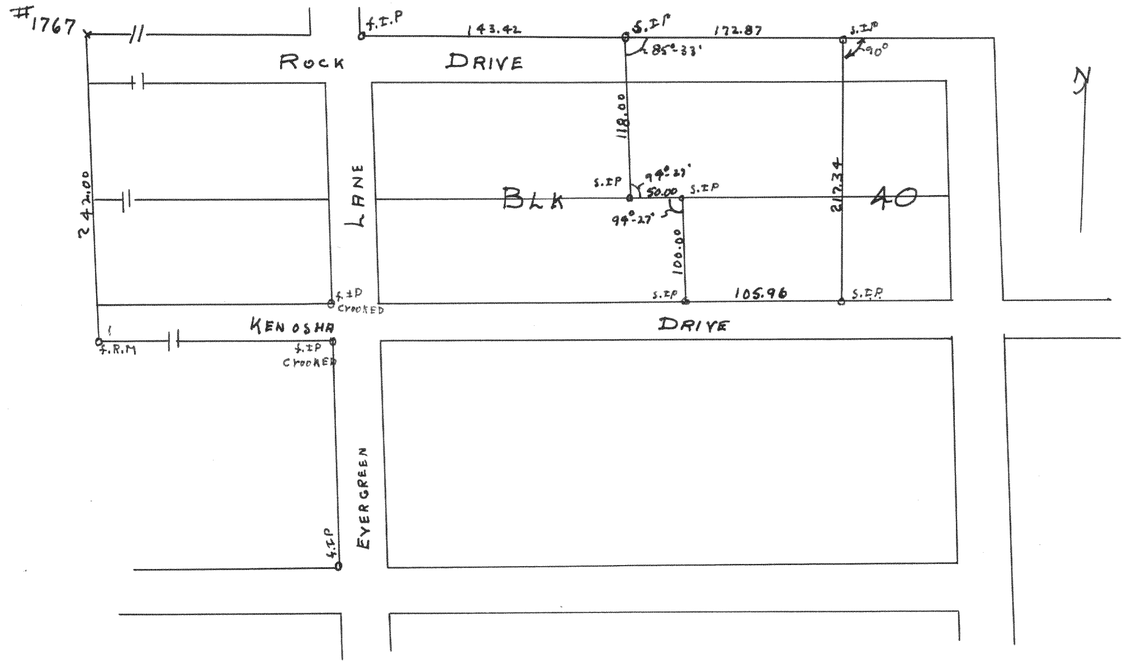

Plat of survey of part of Block 40 in Lake Mandawega Subdivision Walworth County, Wisconsin

Nov. 19, 1947

Lloyd L Jensen
County Surveyor