

#1778

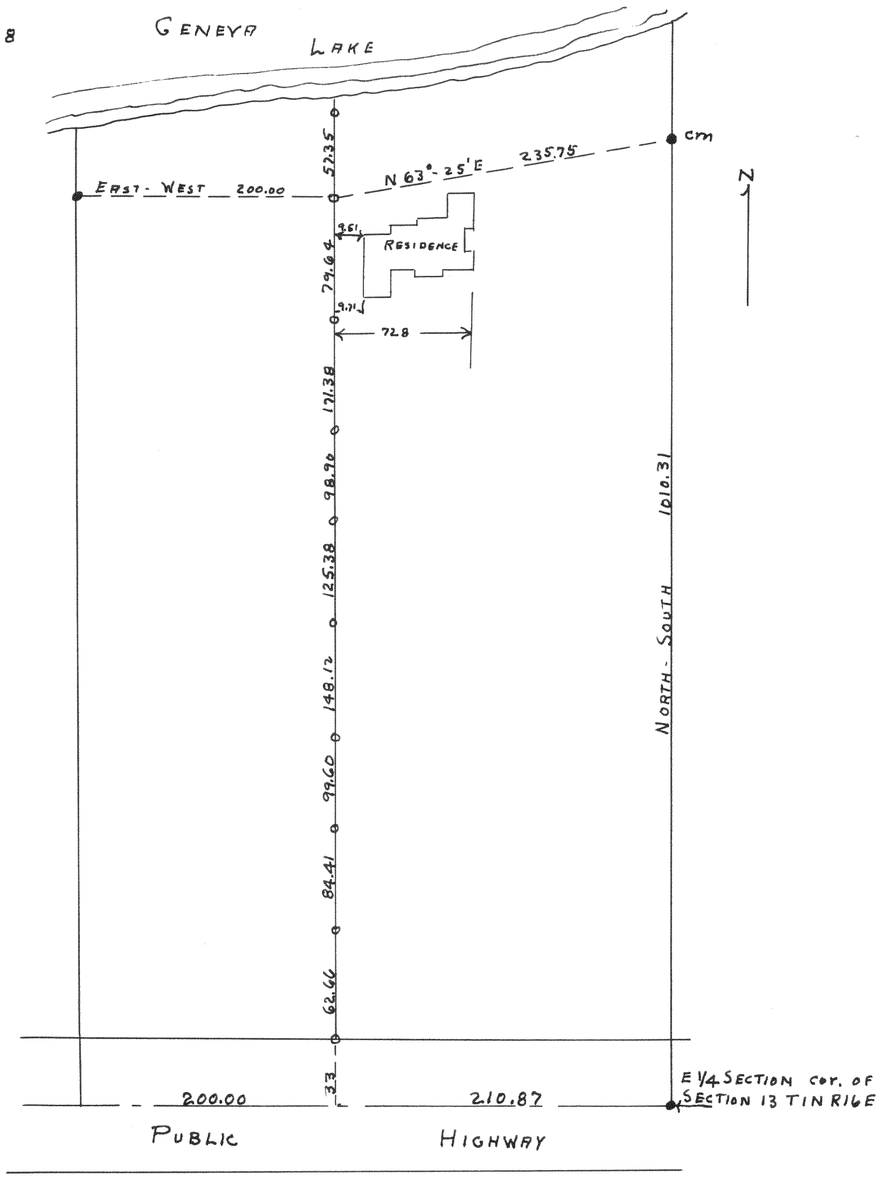

Plat of survey of parcel of land located in the NE ¼ of Section 13 T1N R16E of Walworth County, Wisconsin
June 19 1947

Lloyd S Jensen
County Surveyor

#1779

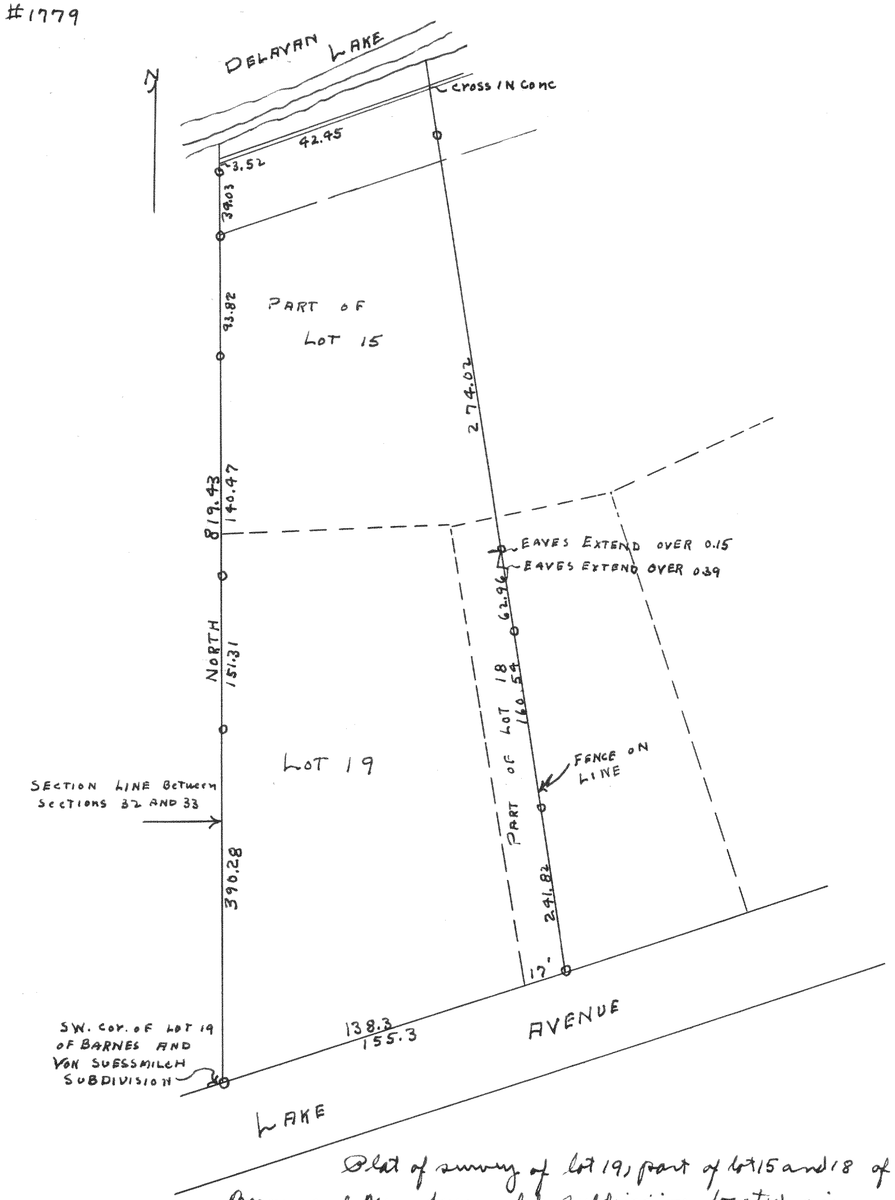

Plat of survey of lot 19, part of lot 15 and 18 of Barnes and Van Suessmilch subdivision located in Section 33 T2N R16E of Walworth County, Wisconsin

September 1947

Lloyd S Jensen
County Surveyor