
#1781

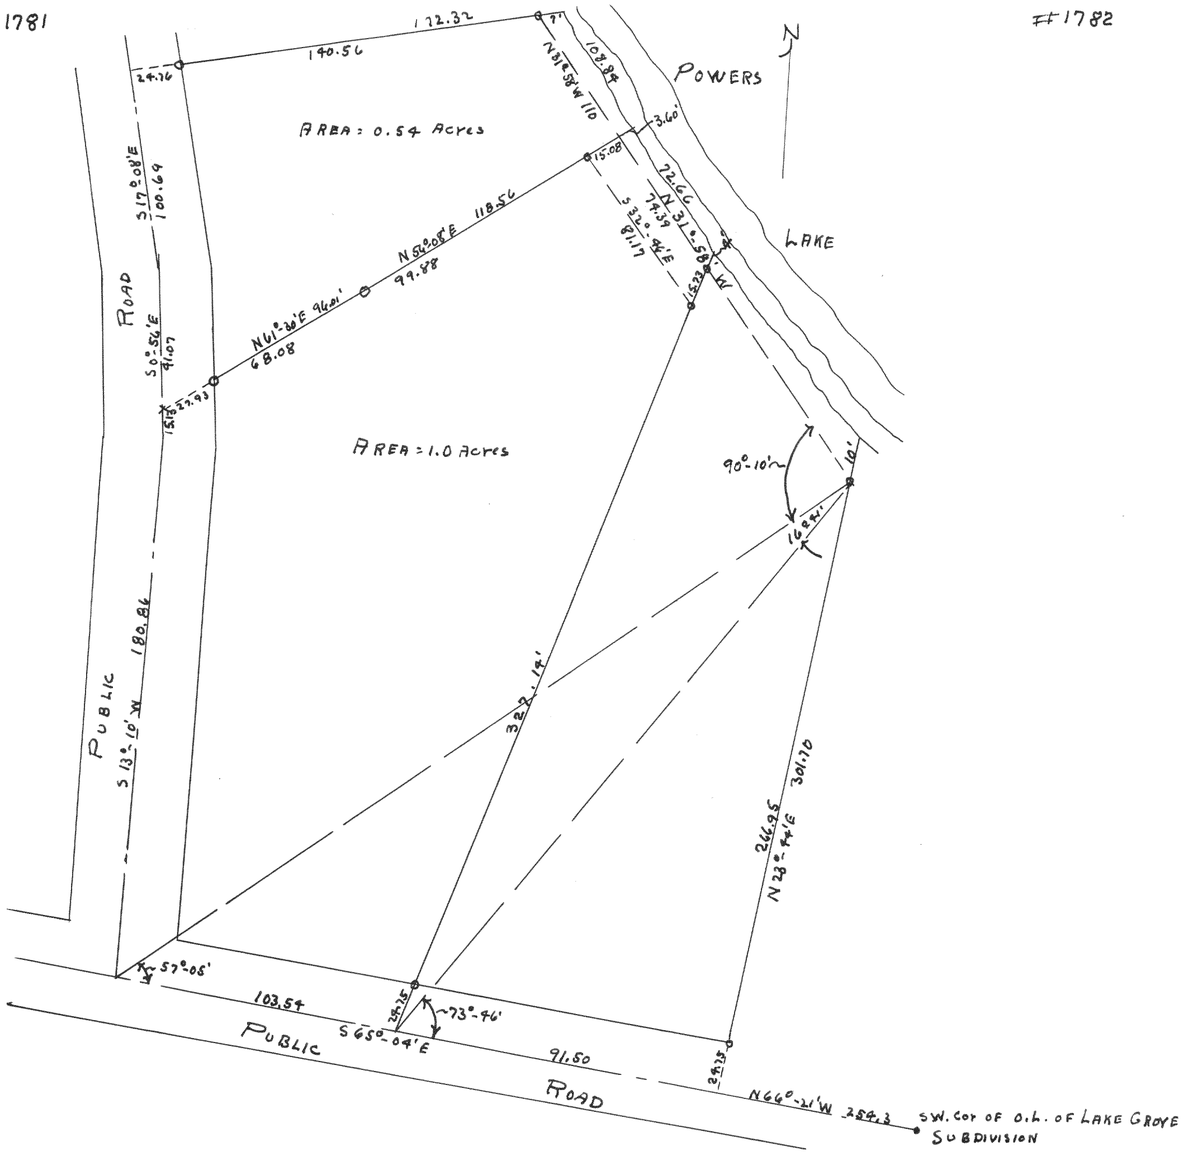


Plat of survey of a parcel of land located in the SE fractional ¼ of Section 13-T1N-18E of Walworth County, Wisconsin

Nov. 1947

Floyd F Jensen
County Surveyor
wisc

#1782

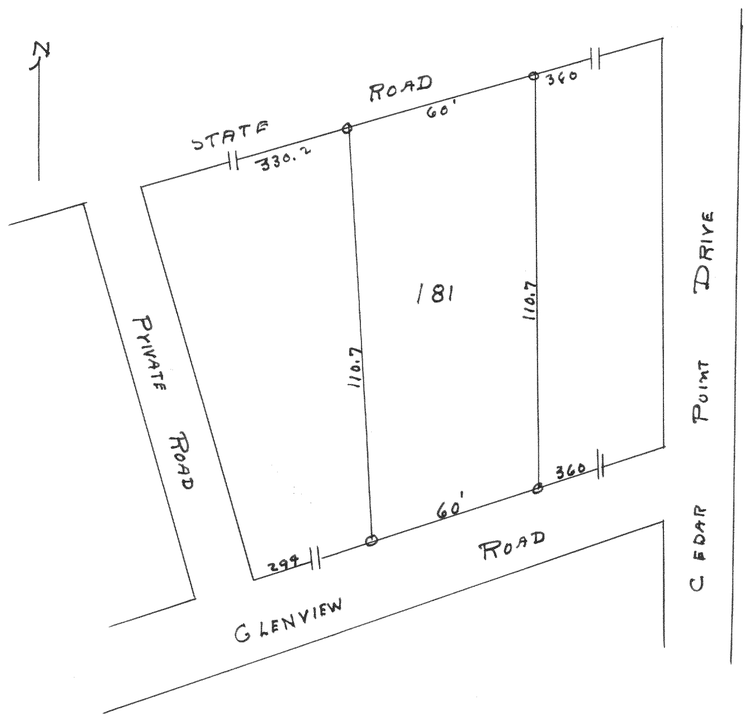

Plat of survey of lot 181 in 2nd Addition to Cedar Point Park subdivision, Village of Williams Bay Walworth County, Wisconsin

April 5, 1947

Floyd F Jensen
County Surveyor
wisc