
1785

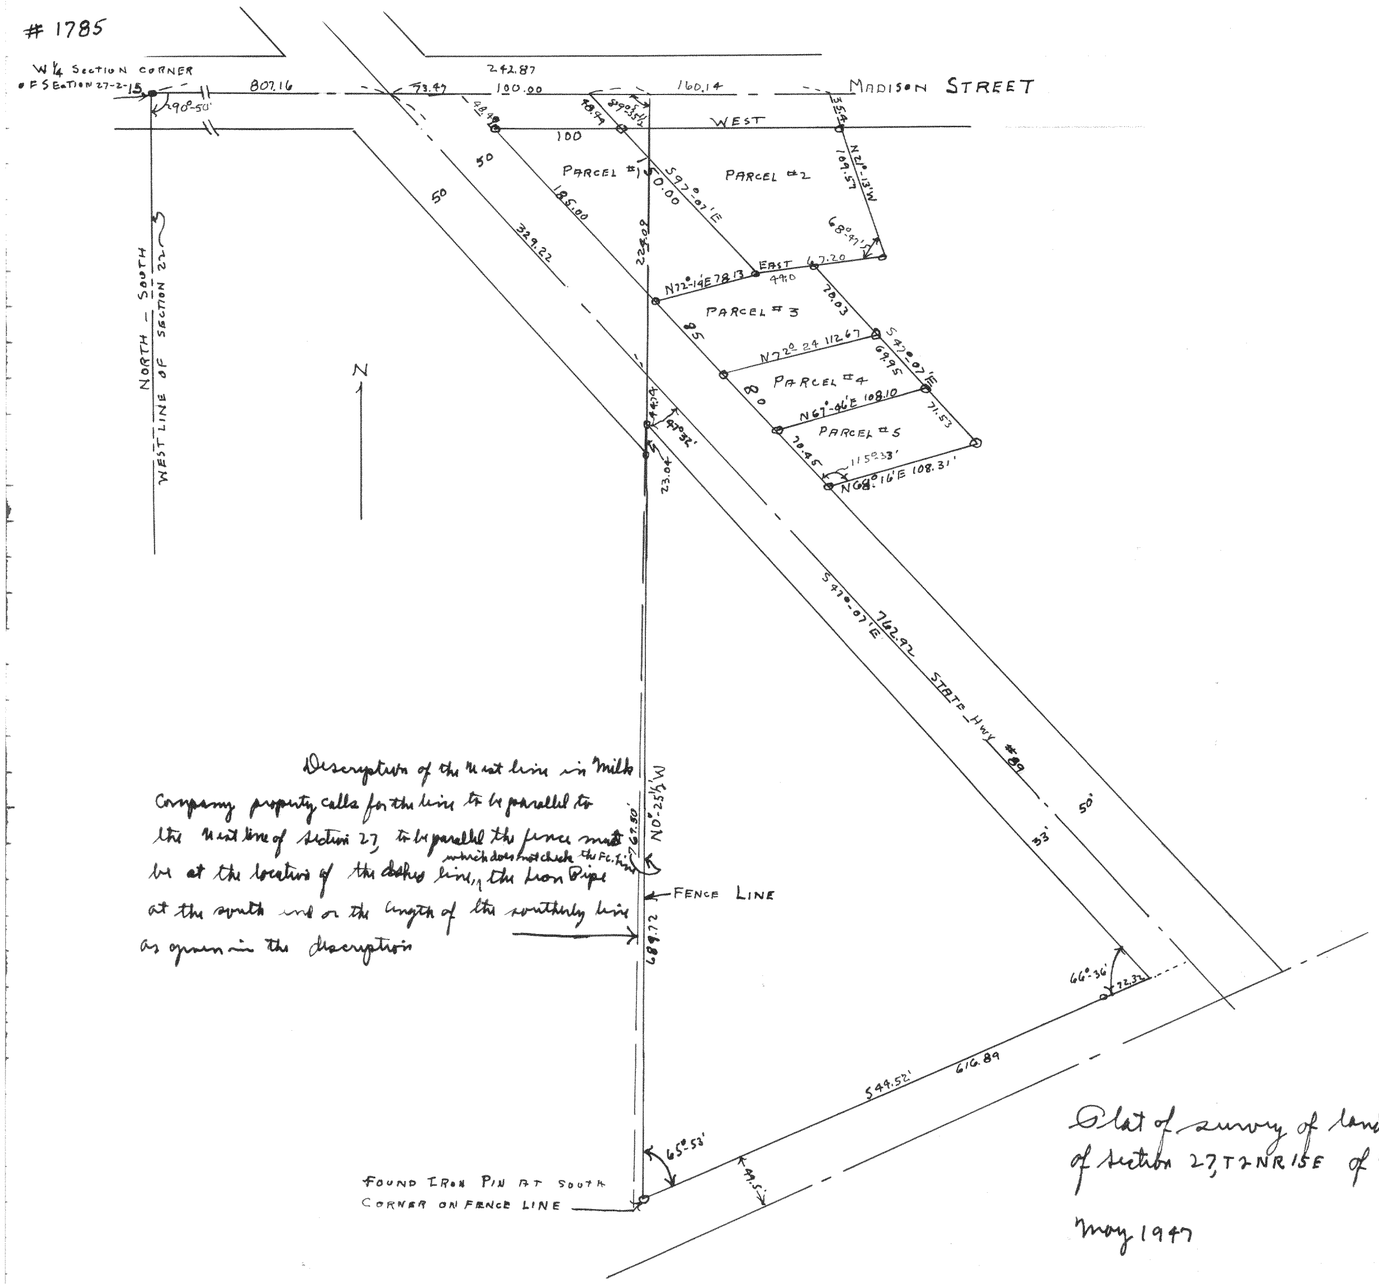

Description of the west line in Milk Company property calls for the line to be parallel to the west line of Section 27 to be parallel the fence must be at the location of the clothes line, the Iron Pipe at the south end of the length of the southerly line as given in the description

which does not check the Pc. line

Plat of survey of land located in the Southwest ¼ of Section 27, T 2 N R 15 E of Walworth County, Wisconsin

May 1947

Floyd I Jensen
County Surveyor