#1787

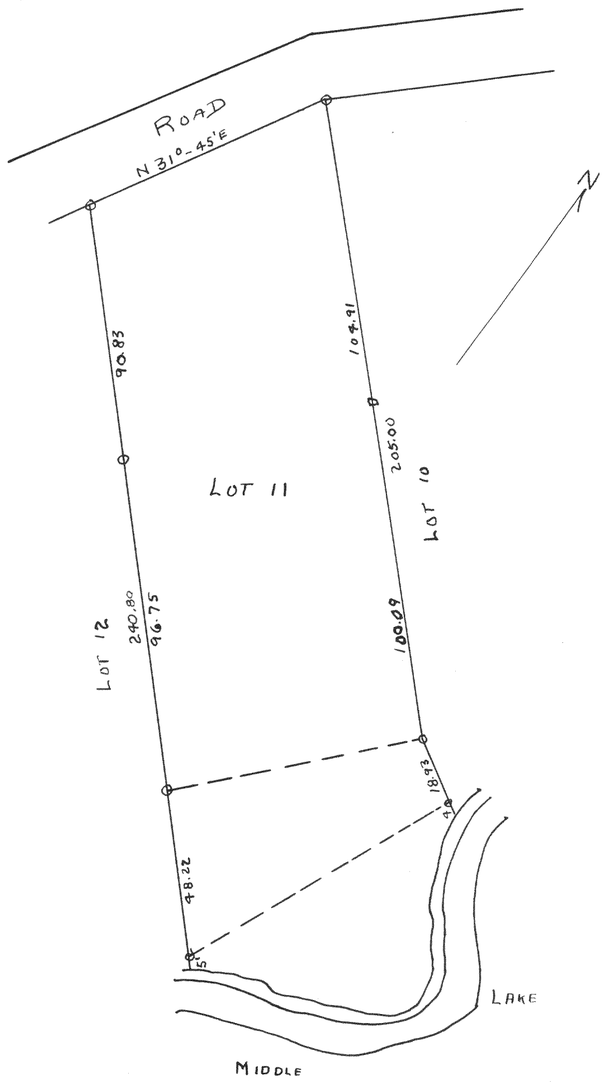

Plat of survey of Lot 11 of Oak Park Subdivision located in Section 26 T4N R16E of Walworth County Wisconsin

1946

Lloyd T Jensen
County Surveyor

#1788

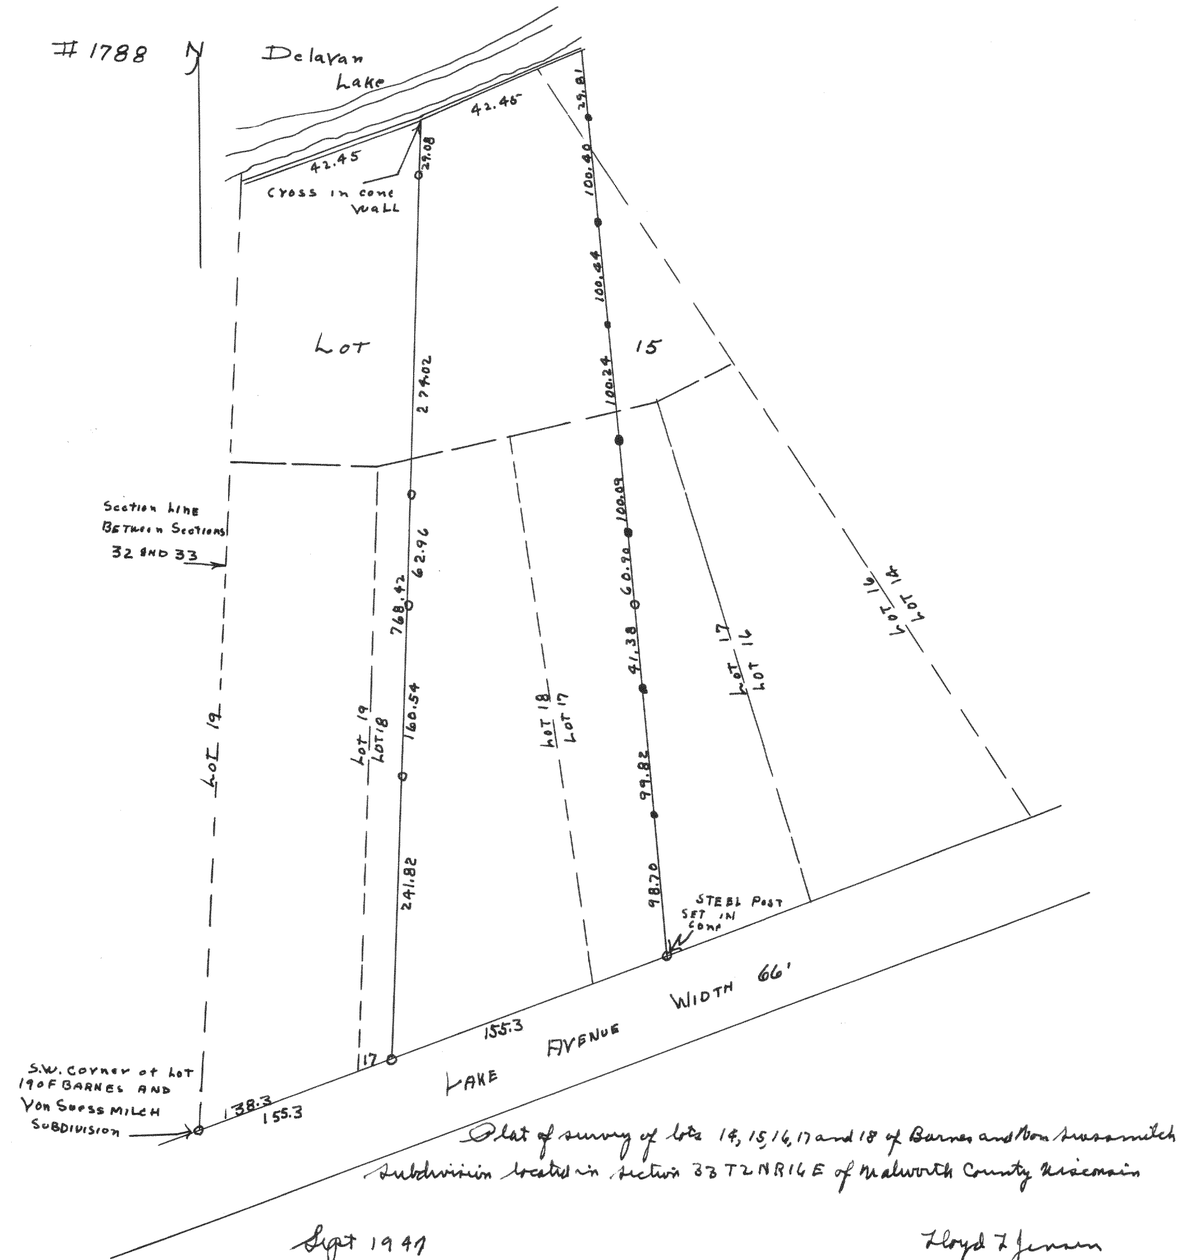

Plat of survey of lots 14, 15, 16, 17 and 18 of Barnes and Von Suessmilch Subdivision located in Section 33 T2N R16E of Walworth County Wisconsin

Sept 1947

Lloyd T Jensen
County Surveyor