
#1790

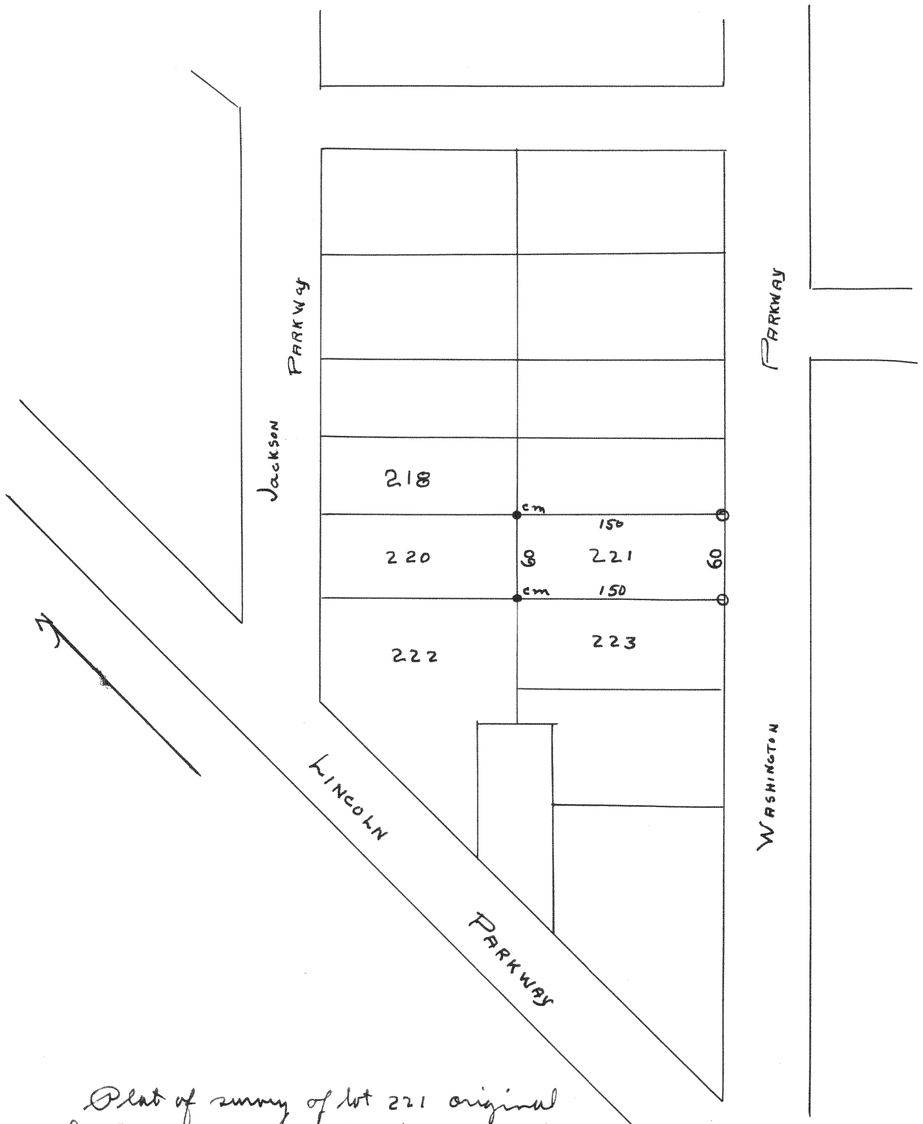


Plat of survey of lot 221 original Cedar Point Park subdivision located in the Village of Williams Bay, Walworth County Wisconsin

Sept 1946

Lloyd I Jensen
County Surveyor

#1791

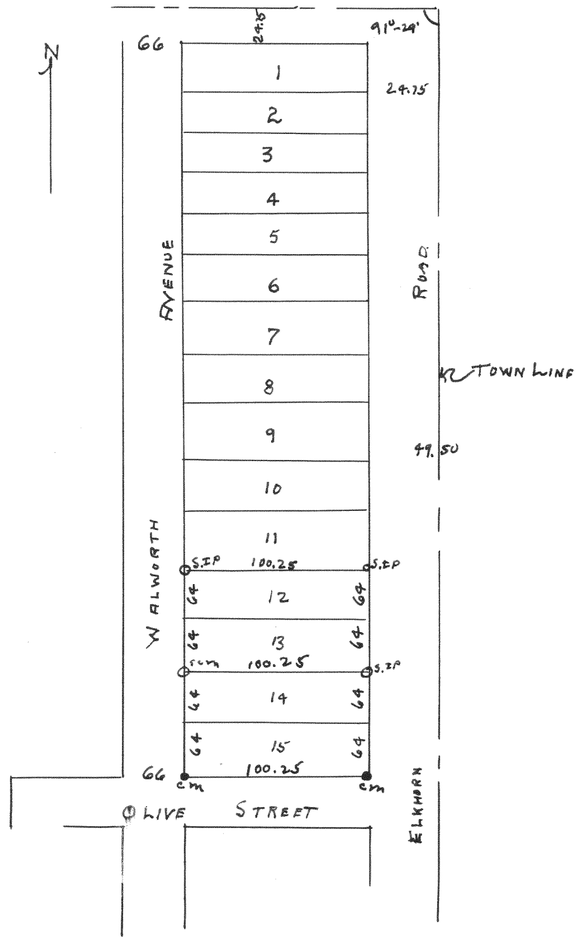

Plat of survey of lots 12 and 13 of William H Francis subdivision in the Village of Williams Bay, Walworth County Wisconsin
1947

Lloyd I Jensen
County Surveyor