
#1799

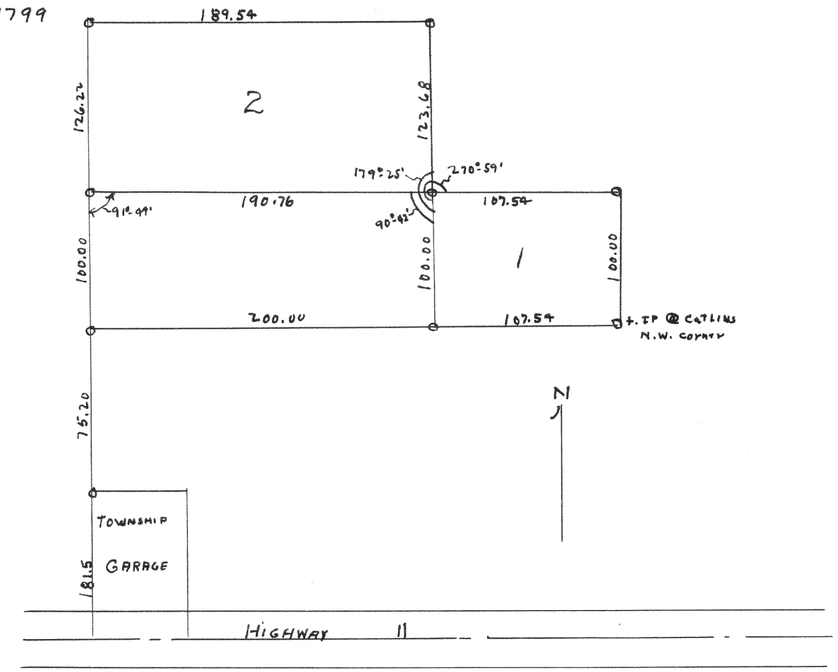


Plat of survey of parcels 1 and 2 located in the NE¼ of Section 24 T3N R17E of Walworth County, Wisconsin

July 16, 1947

Floyd L Jensen
County Surveyor

#1800

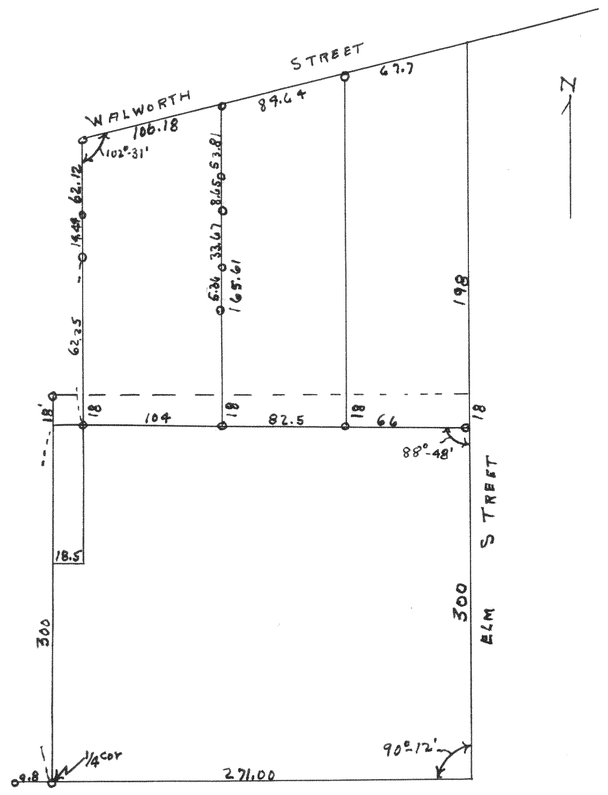

Plat of survey of Clyde M. Blakesley land located on N. Walworth St City of Elkhorn, Walworth County, Wisconsin

May 5, 1947

Floyd L Jensen
County Surveyor