
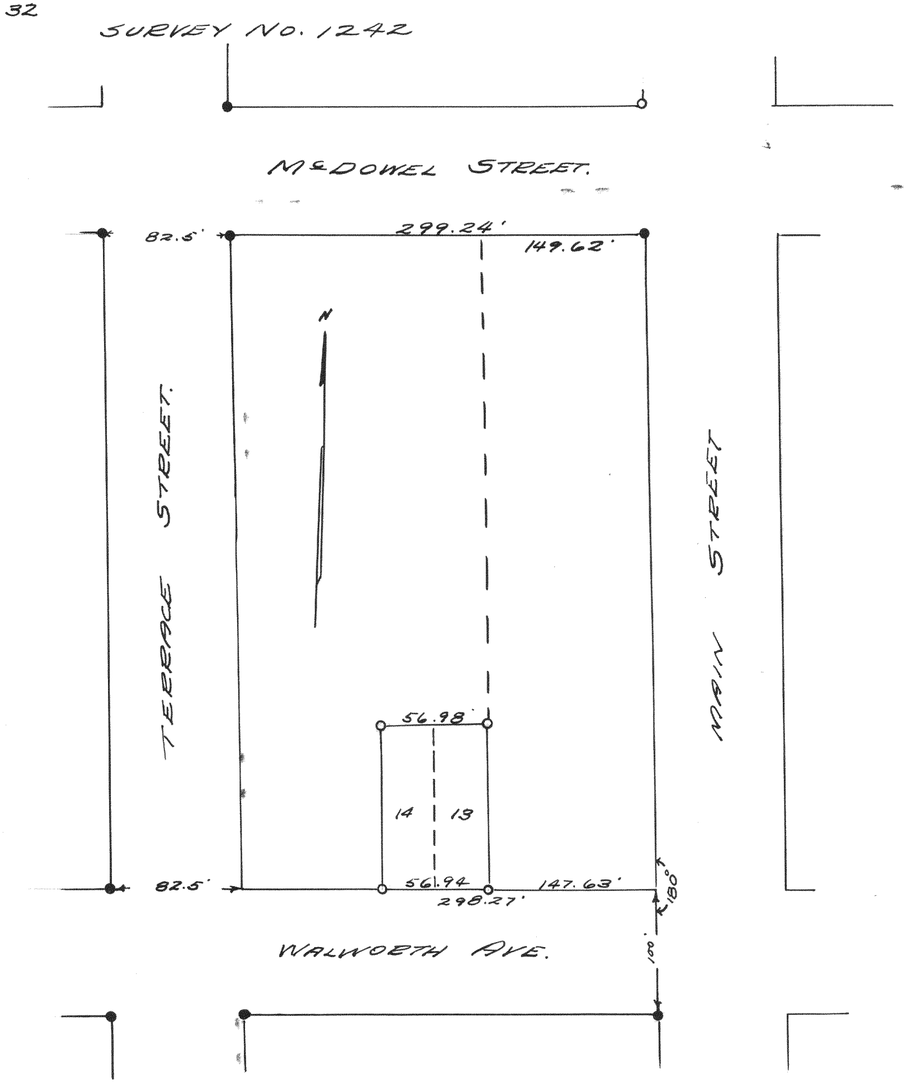


PLAT OF SURVEY OF LOT 13 AND LOT 14 EXCEPT THE WEST 1.3 FEET OF LOT 14 OF BLOCK 7 OF THE ORIGINAL PLAT OF THE VILLAGE (NOW CITY) OF DELAVAN, WALWORTH COUNTY, WISCONSIN, APRIL 4, 1941

Lloyd L. Jensen
R.E.J.

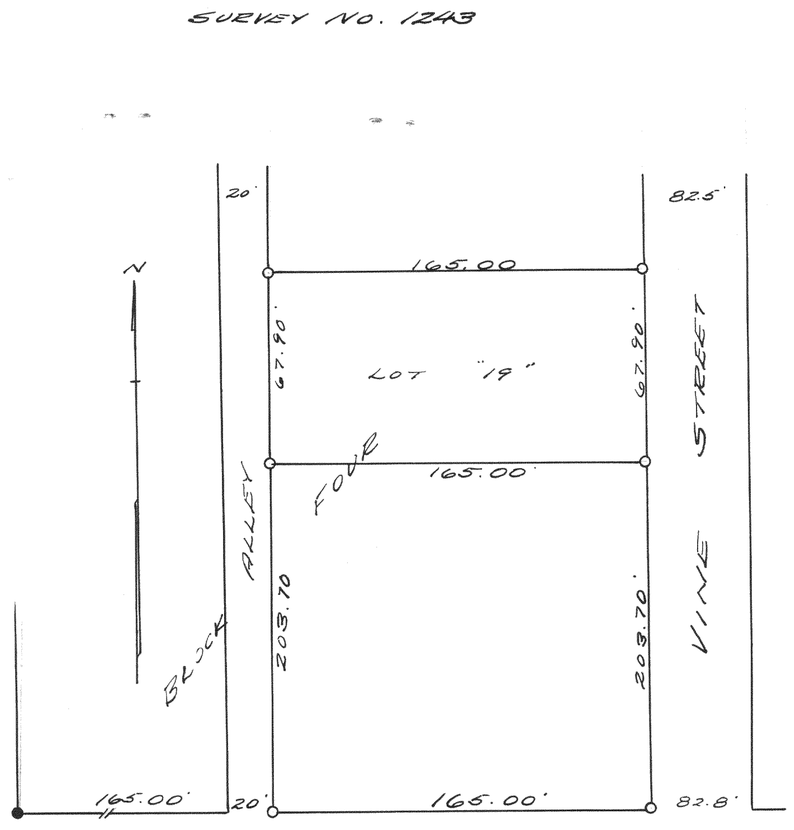

PLAT OF SURVEY OF LOT 19, BLOCK 4 OF F.K. PHOENIX ADDITION TO THE CITY OF DELAVAN, WALWORTH COUNTY, WISC. JUNE 9, 1941

Lloyd L. Jensen
R.E.J.