
#1805

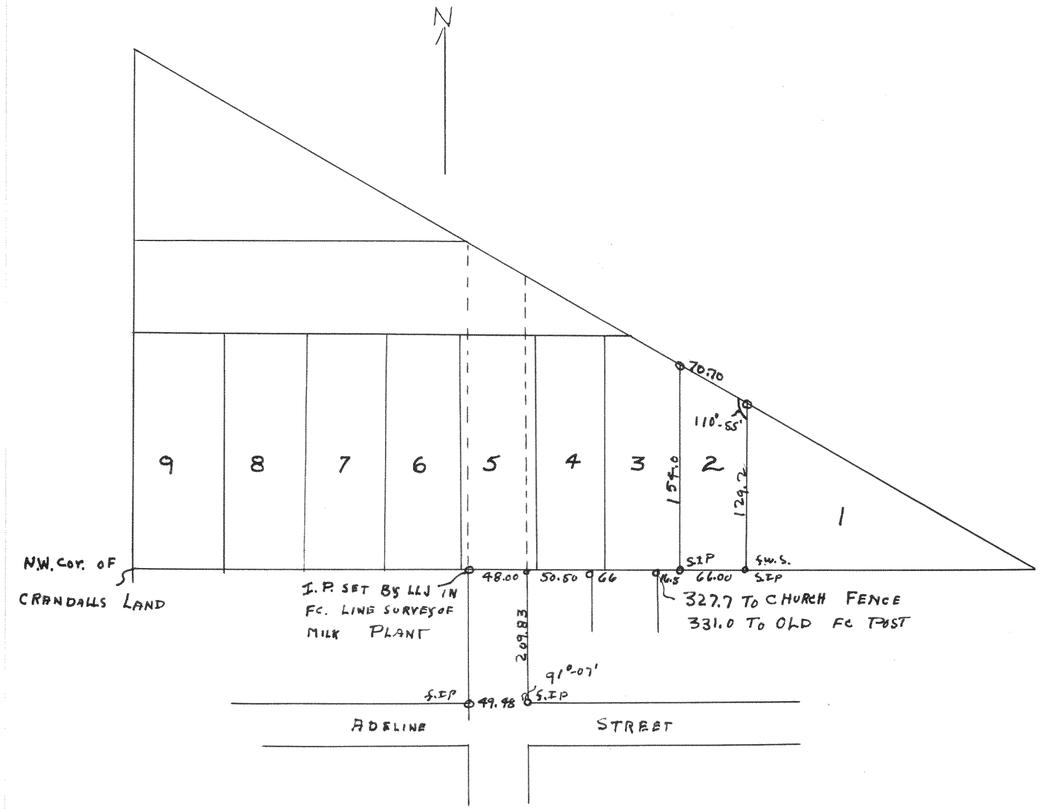


Plat of survey of Lot 2 of Longworth Subdivision located in the Village of Walworth, Walworth County, Wisconsin

Sept 5, 1947

Lloyd L Jensen
County Surveyor

#1806

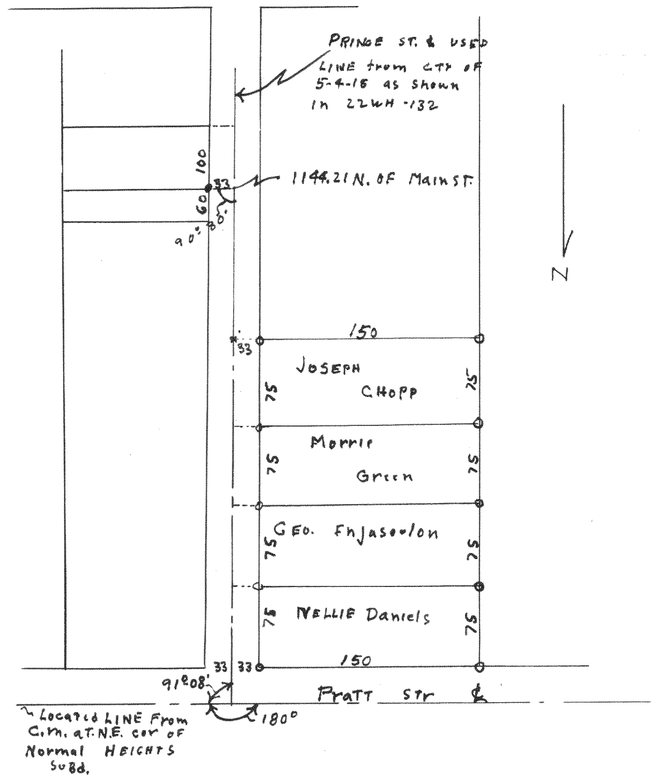

Plat of survey of parcels of land along Prince street starting at the corner of Prince and Pratt street in the city of Whitewater Walworth County, Wisconsin

April 21, 1947

Lloyd L Jensen
County Surveyor